




# T. 4 S., R. 10 W., W.M.

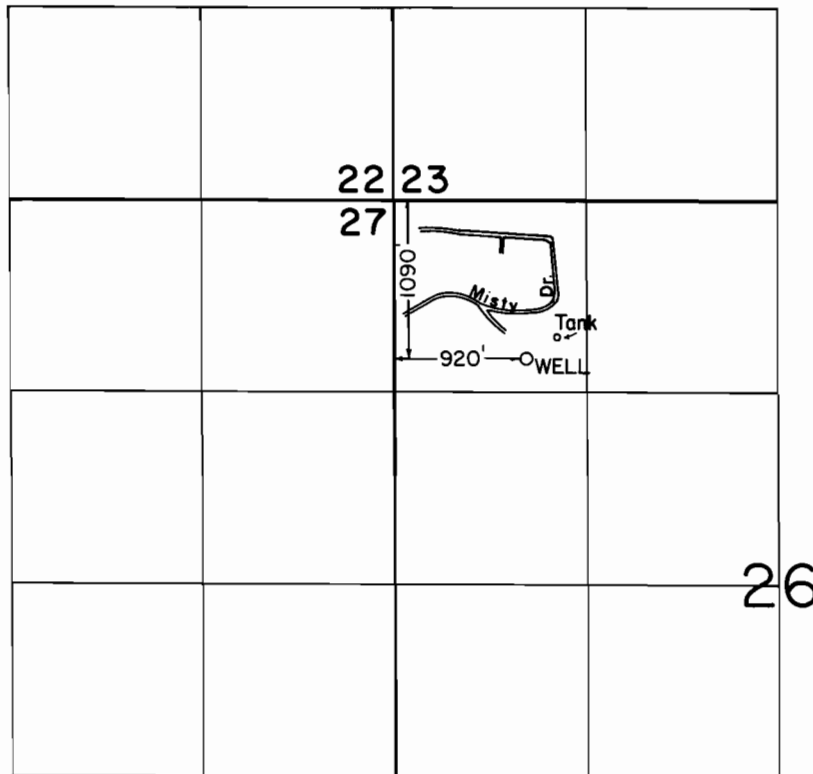

SCALE: 1" = 1320'

## FINAL PROOF SURVEY UNDER

Application No. G-10992 Permit No. G-10342...  
IN NAME OF

**CLOVERDALE WATER DISTRICT**

Surveyed SEPT. 30. 1987., by B. W. BISHOP.....