


T.19S., R.44E., W.M.

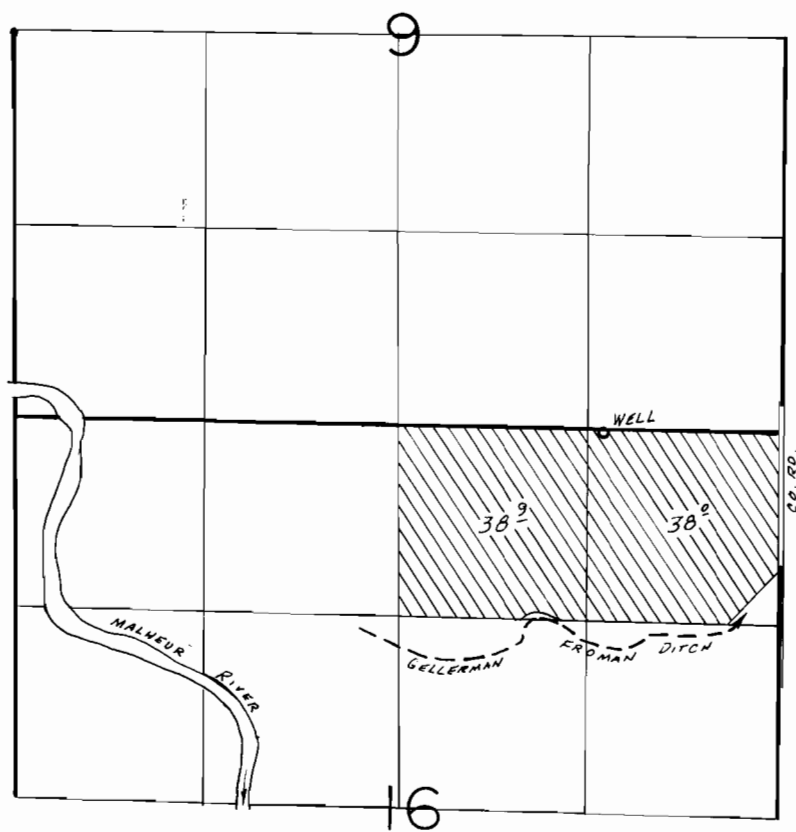

WELL LOC.: 40'S. & 1240' W. FROM NE COR. SEC. 16.

SCALE: 1" = 1320'

### FINAL PROOF SURVEY UNDER

Application No. G-11162. Permit No. G-10336...  
IN NAME OF

.....GEORGE RECLA.....

Surveyed Apr. 17... 19.86, by L.M. TOLL.....

3/10/87 BWS  
BBC-6N-26