



T. 6N., R. 35E., W.M.

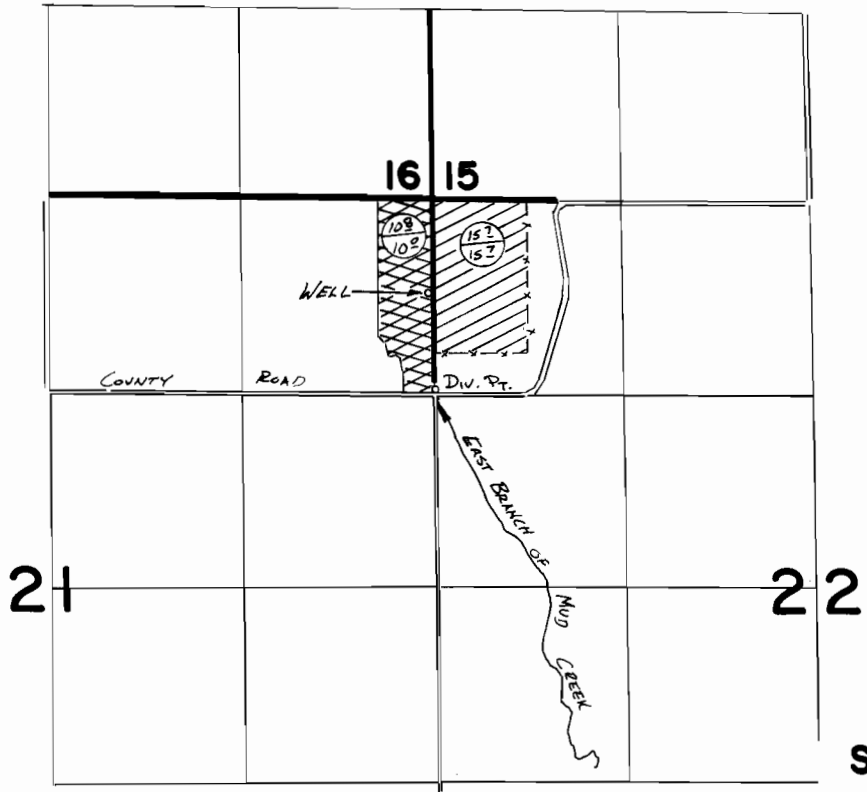

SCALE 1" = 1320'

- ⊗ WELL LOC. 690' N. & 30' W FROM SE COR NE 1/4 NE 1/4 SEC 21
- ⊗ Div. Pt. LOC. 20' N. FROM SE COR. NE 1/4 NE 1/4 SEC 21

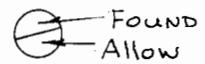

FINAL PROOF SURVEY
UNDER

G-11473 G-10665
 Application No. **68645** Permit No. **49875**...
 IN NAME OF

.....**R. G. RENCKEN**.....

Surveyed 4-28..... 1987.., by V. L. Church.....