


T. 35 S., R. 2 W., W. M.

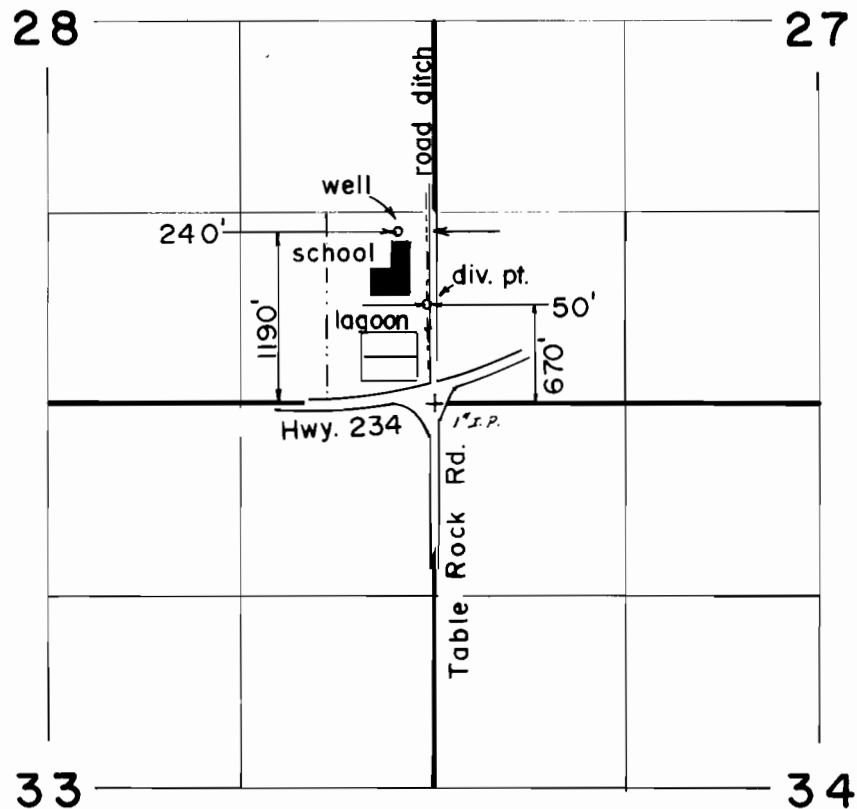

Scale: 1" = 1320'

FINAL PROOF SURVEY UNDER

G-11405

G-10663

Application No. 68409 Permit No. 49884...

IN NAME OF

.....SCHOOL.....DISTRICT.....6.....

Surveyed MAY 12, 1987, by B. S. JAMES.