



910665
62703

T 6N., R. 35E., W.M.

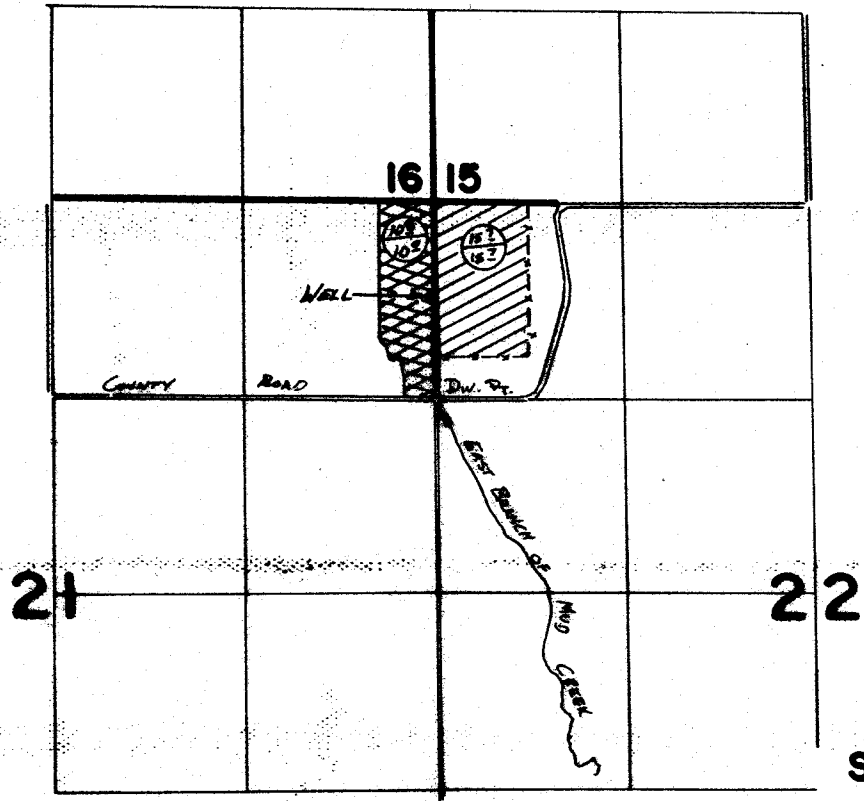

SCALE 1" = 1320'

- ⊗ WELL Loc. 690' N. & 90' W. FROM SE COR NE 1/4 NE 1/4 SEC 21
- ⊗ Div. Pt. Loc. 20' N. FROM SE COR. NE 1/4 NE 1/4 SEC 21

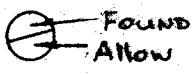

FINAL PROOF SURVEY
UNDER

G-11473 G-10665
 Application No. **68645** Permit No. **49975**...
 IN NAME OF

..... **R. G. RENCKEN**

Surveyed 4-28..... 1987, by V.L. Church.....