




T. 40 S., R. 20 E., W.M.

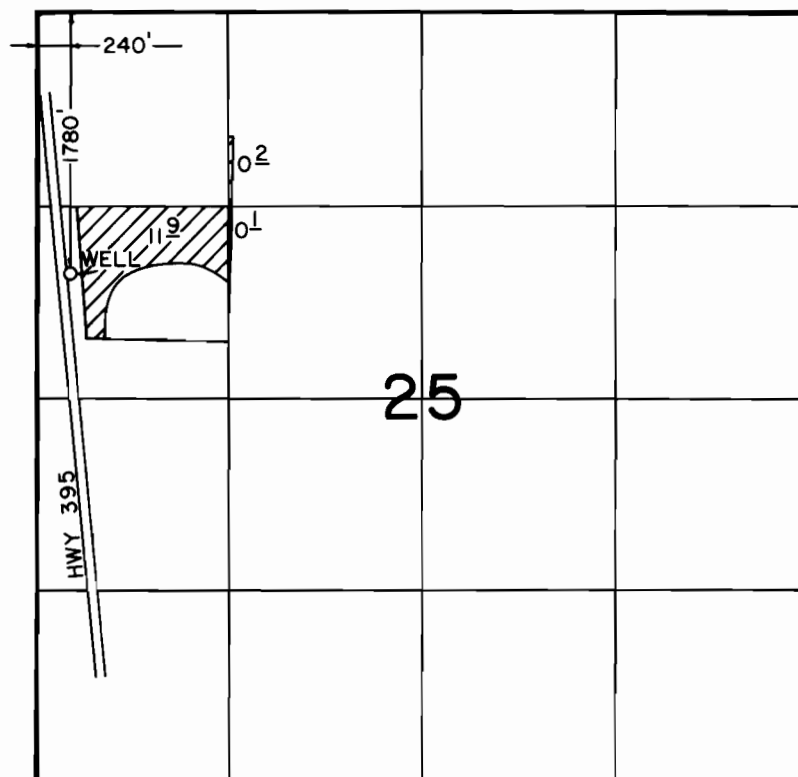

SCALE : 1" = 1320'

FINAL PROOF SURVEY UNDER

Application No. G-11513 Permit No. G-10603
IN NAME OF

VINCENT 2C RANCH

Surveyed OCT. 15, 1987, by V. L. CHURCH