



210658  
62706

T. 2N., R. 33E., W.M.

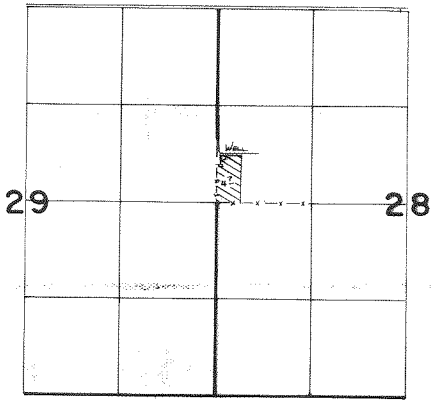

Well Loc: 600'N. & 80'E From W/4 Cor. Sec 28

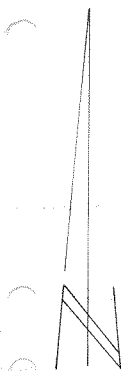

SCALE 1" = 1320'

**FINAL PROOF SURVEY**  
UNDER

Application No. **G:11560** Permit No. **G:10658**  
IN NAME OF

.....**HERMAN W. CAREY**.....

Surveyed 2-3..... 1982, by *V.L. Church*.....