


210668  
62708

T. 2N., R. 33E., W. M.

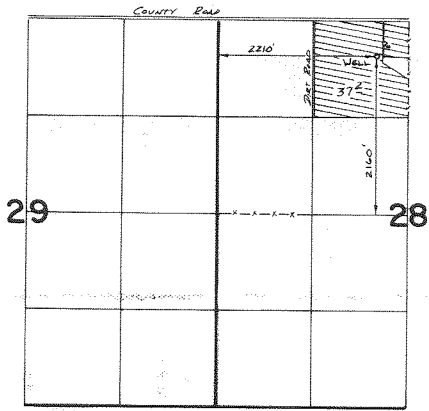

SCALE 1" = 1320'

**FINAL PROOF SURVEY**  
UNDER

Application No. **G:11570** Permit No. **G:10668**  
IN NAME OF

**JOSEPH RALPH McDONALD JR.**

Surveyed 9-3 1987, by V.L. Church