


T. 35 S., R. 6 W., W.M.

SECTION 31

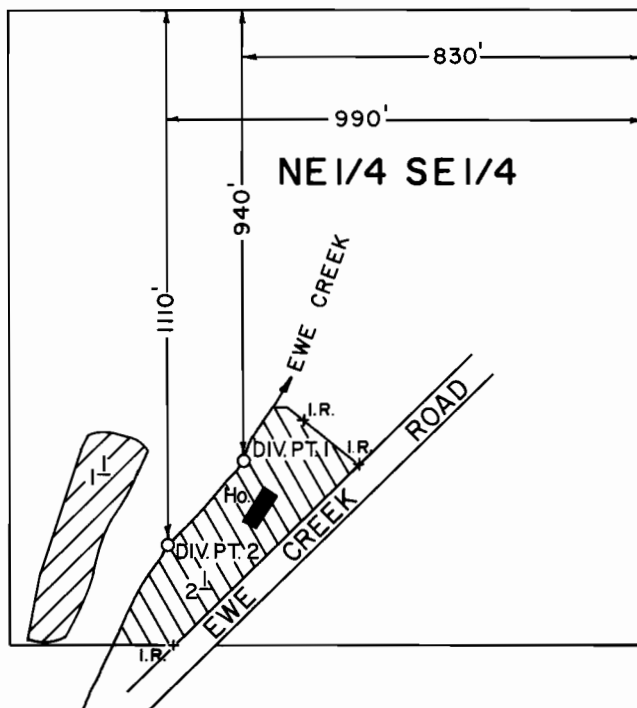

SCALE: 1"=400'

 DIV. PT. 1
 DIV. PT. 2

FINAL PROOF SURVEY

UNDER

Application No. **54182**. Permit No. **40561**.....
IN NAME OF

JIMMY K. FIERLING

Surveyed MAY 16 1989, by B. S. JAMES