


T. 25S., R. 12W., W.M.

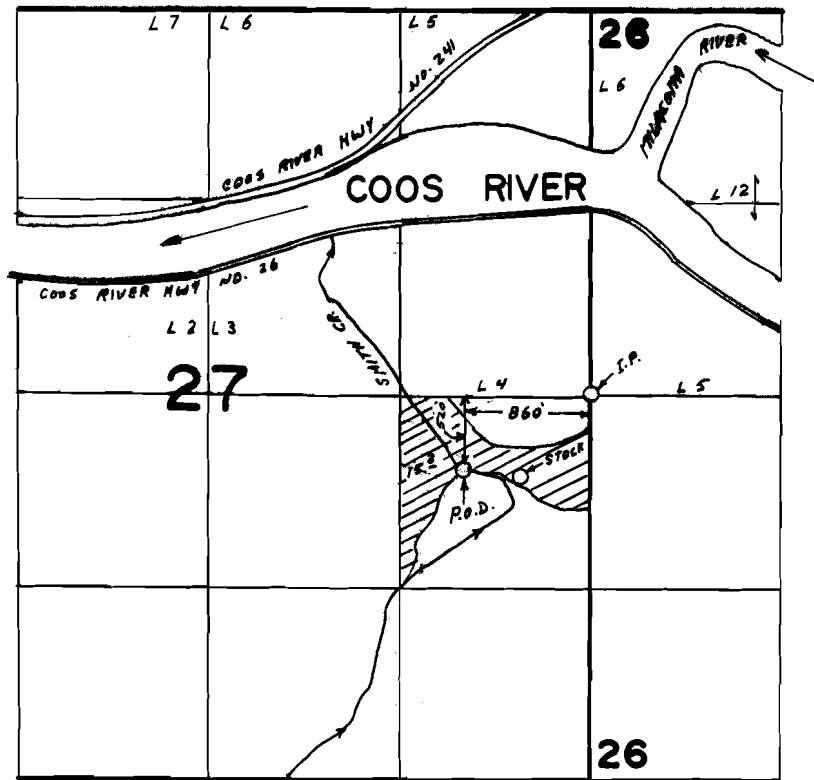

SCALE 1" = 1320'

FINAL PROOF SURVEY UNDER

Application No. **56380** Permit No. **42170**

IN NAME OF

GEORGE W. SMITH

Surveyed **JUN 23 19 87**, by **M. SCHMORDE**

41011-180-238 B
6-16-89 Z.F.S.