




T. 26 S., R. 13 W., W.M.

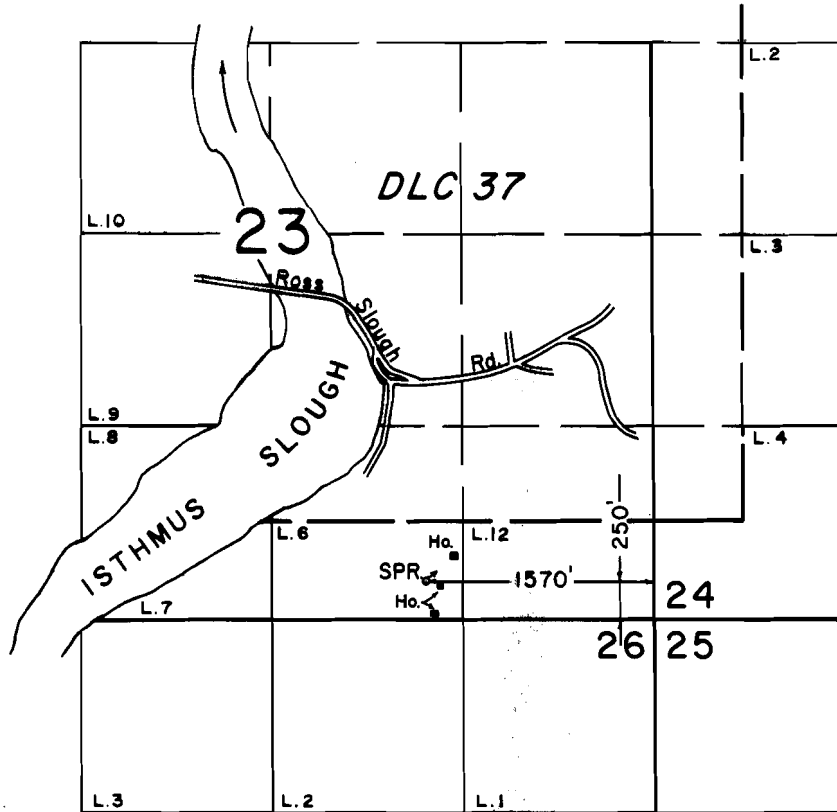

SCALE: 1" = 1320'

FINAL PROOF SURVEY
UNDER

Application No. 56281.. Permit No. 42822.....
IN NAME OF

WALTER & CATHERINE TYMICH

Surveyed JUNE 24 1987, by J. M. SCHMORDE