


T. 5 S., R. 3 E., W. M.

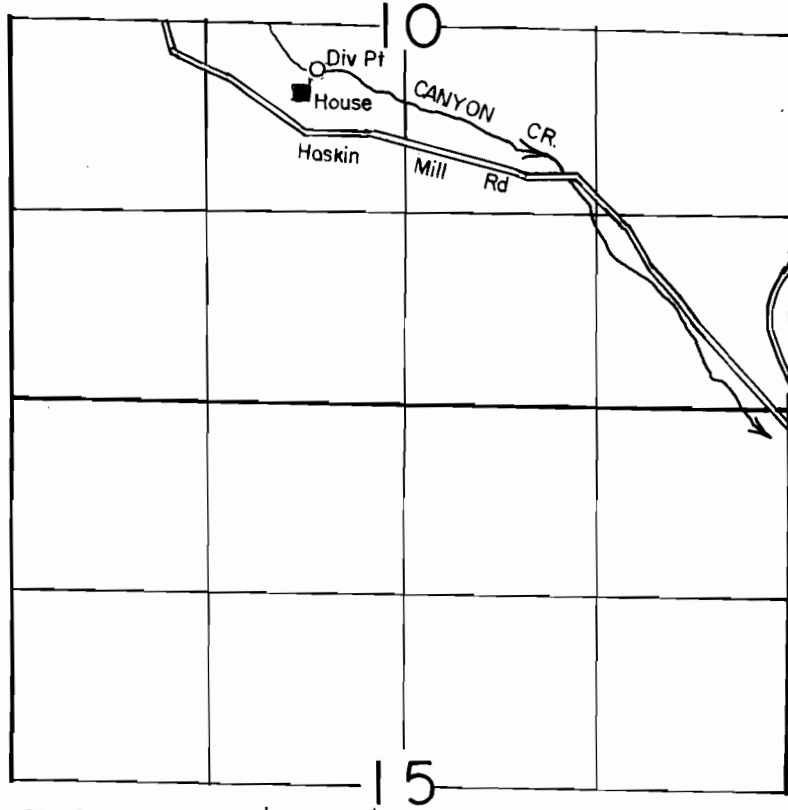

DIV. PT. LOCATED 350' S. & 550' W. FROM CENTER 1/4 SECTION 10

SCALE: 1"=1320'

**FINAL PROOF SURVEY**  
UNDER

Application No. 60095 Permit No. 44899  
IN NAME OF

WILLIAM B & MARJORIE E RICE

Surveyed JULY 16 1987, by T.M. WARREN