


T.10S., R.10W., W.M.

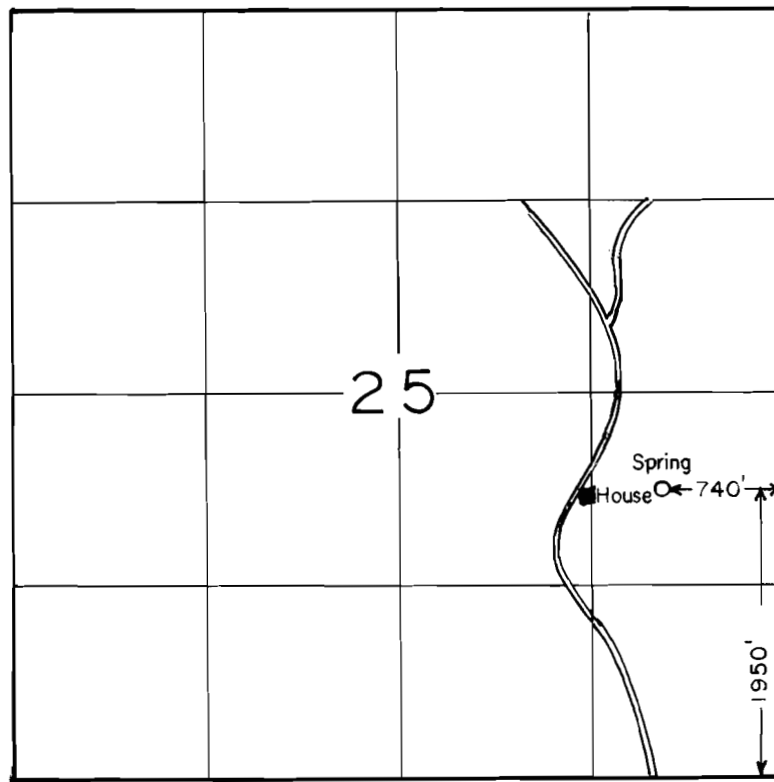

SCALE: 1"=1320'

FINAL PROOF SURVEY
UNDER

Application No. 60281... Permit No. 45553.....
IN NAME OF

BURL P. SHOEMAKE II

Surveyed NOV. 5, 1987, by J.M. WARREN