


T. 2N., R. 4W., WM.

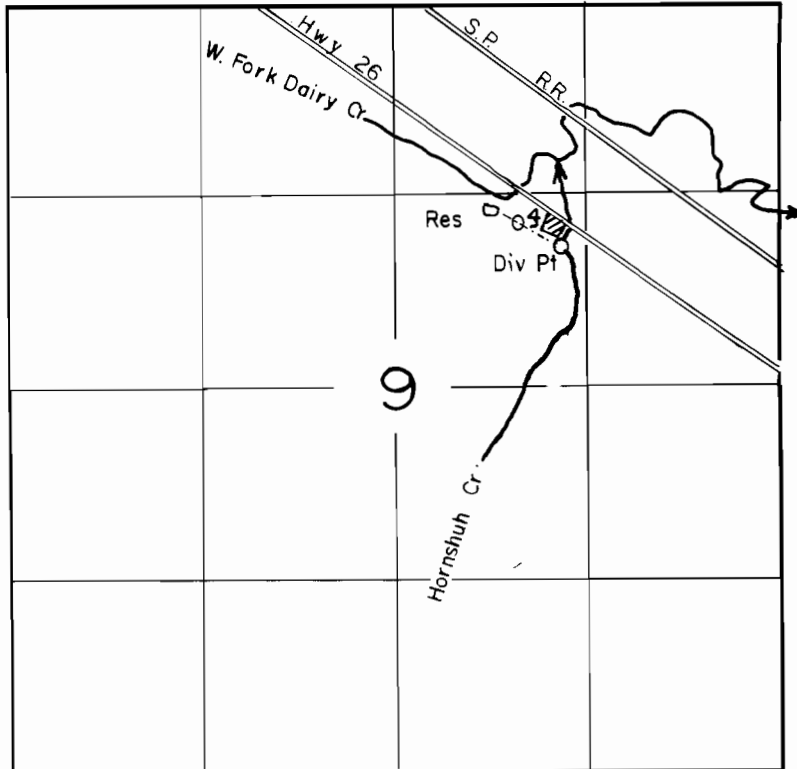

DIV. PT. LOCATED 1650' S & 1500' W FROM NE CORNER SECTION 9

SCALE: 1" = 1320'

FINAL PROOF SURVEY

UNDER

TRANSFER NO. 5513

R- 60566

R- 8257

Application No. 60567... Permit No. 45700.....

IN NAME OF

.....FRED.....HORNSHUH.....

Surveyed JULY 11... 1989., by J.M. WARREN.....