




T. 35 S., R. 6 W., W.M.

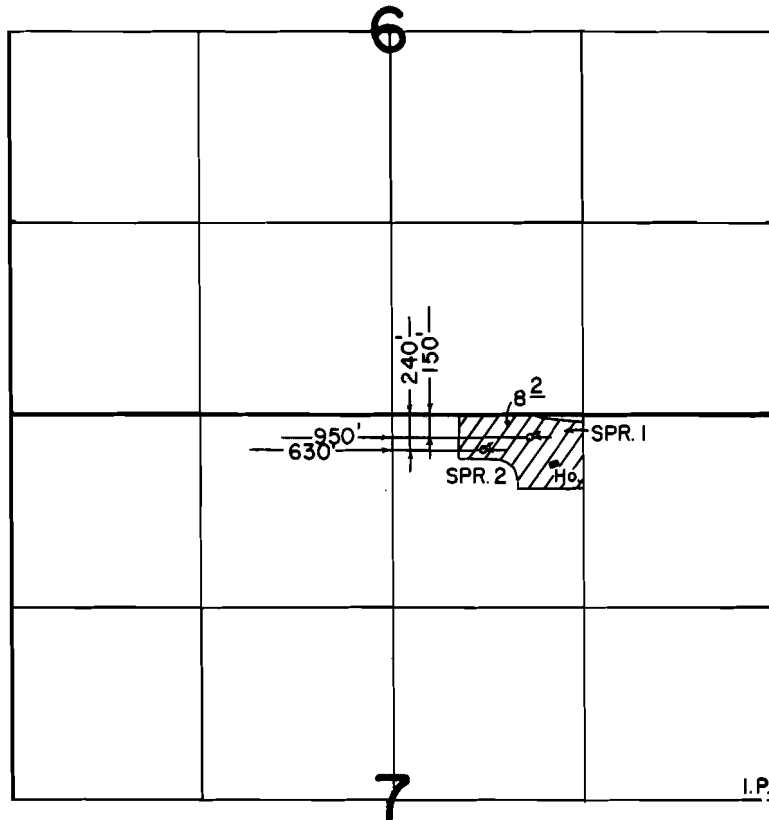

SCALE: 1" = 1320'

FINAL PROOF SURVEY UNDER

Application No. 61584... Permit No. 45807...
IN NAME OF

ROBERT W. ROTACH

Surveyed MAY 16... 1989, by B. S. JAMES