


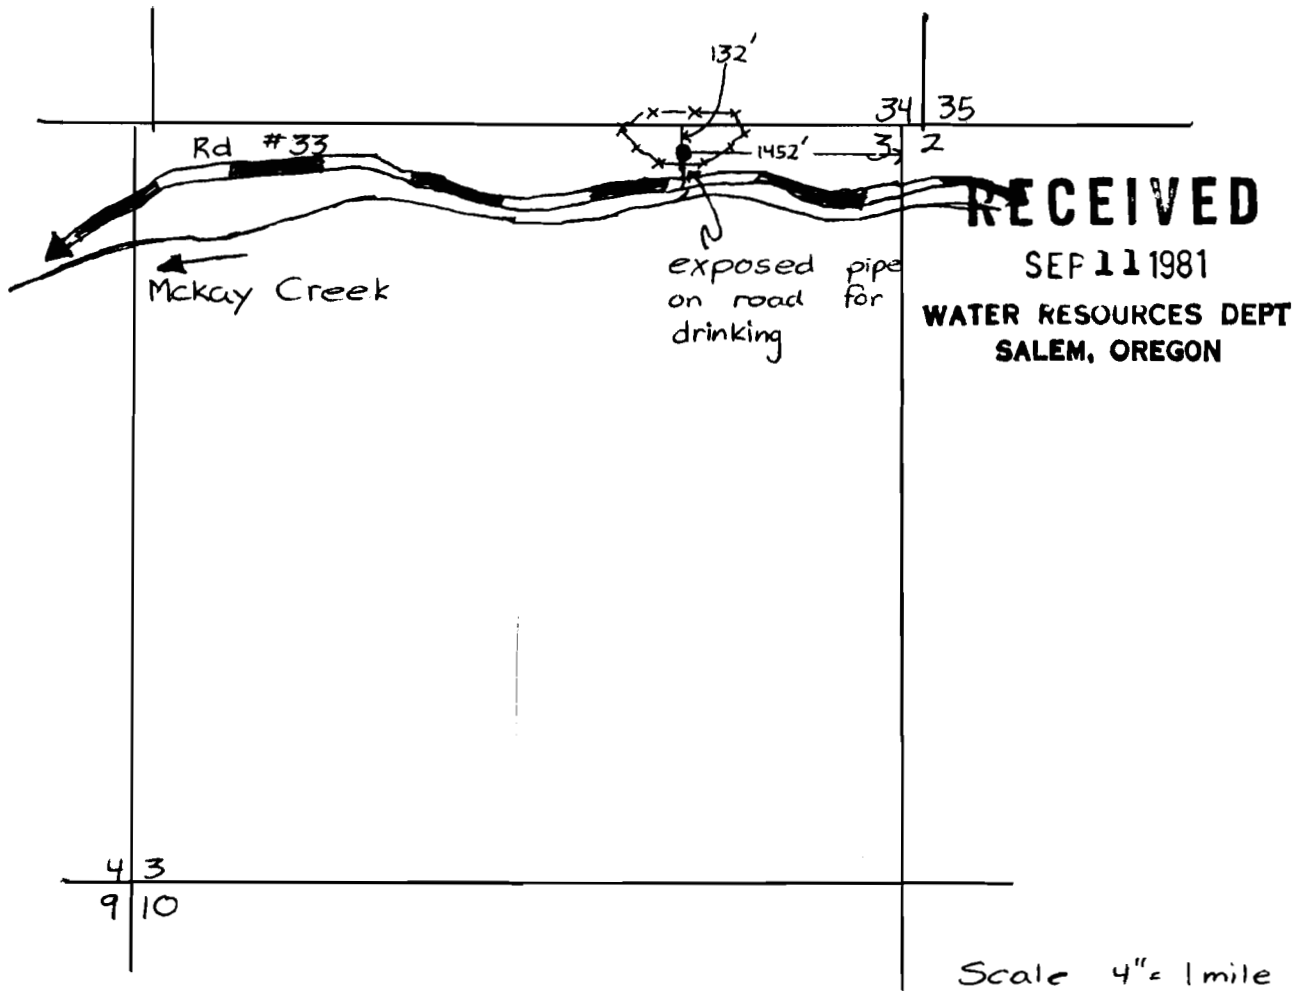

A-Y Spring

NW 1/4, NE 1/4, Sec 3, T13S, R17E, W1M

Application No. 62726

Permit No. 48659

C-62727

48659