


**RECEIVED**

FEB 4 1983

**WATER RESOURCES DEPT.  
SALEM, OREGON**

T. 30 S., R. 3 E., W.M.

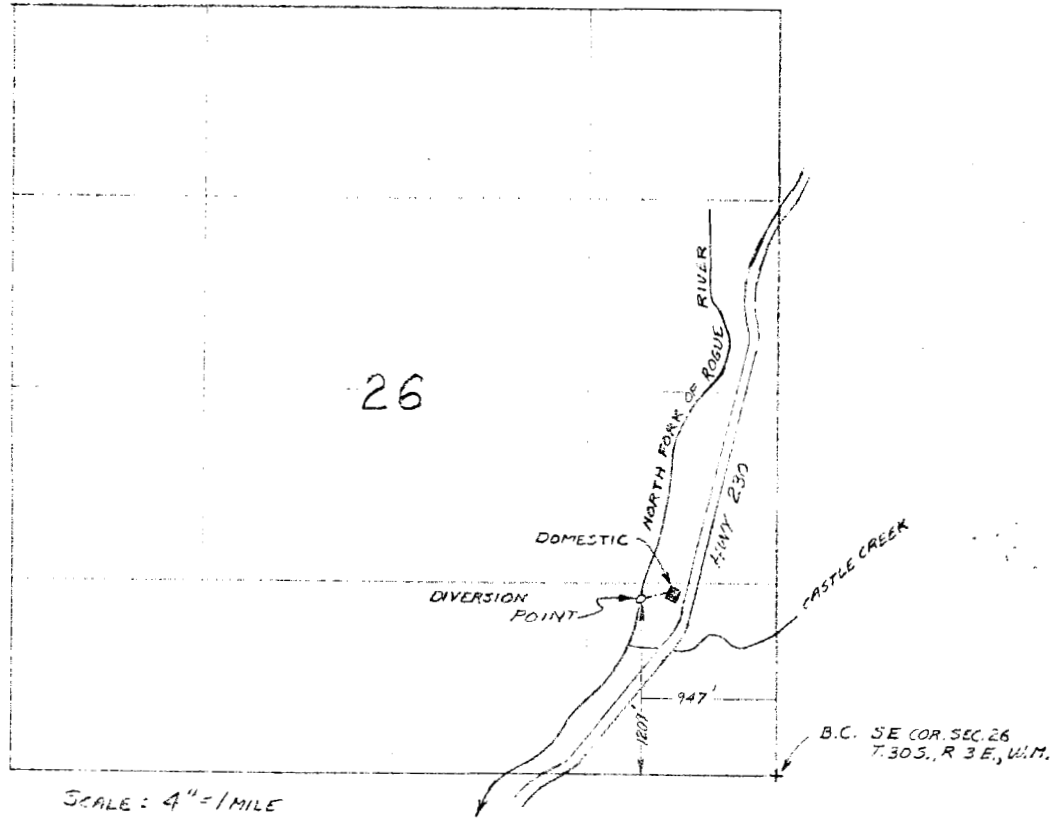

*Div. Pt. Loc.: 1209' NORTH AND 947' WEST FROM THE SE COR. OF SECTION 26,  
T. 30 S., R. 3 E., W.M. BEING WITHIN SE 1/4 OF SE 1/4*

*MAP TO ACCOMPANY APPLICATION OF MICHAEL J. READ TO APPROPRIATE  
WATER FROM NORTH FORK OF ROGUE RIVER FOR DOMESTIC PURPOSES.*

Application No. 63827

Permit No. 47312