




T. 35 S., R. 7 W., W.M.

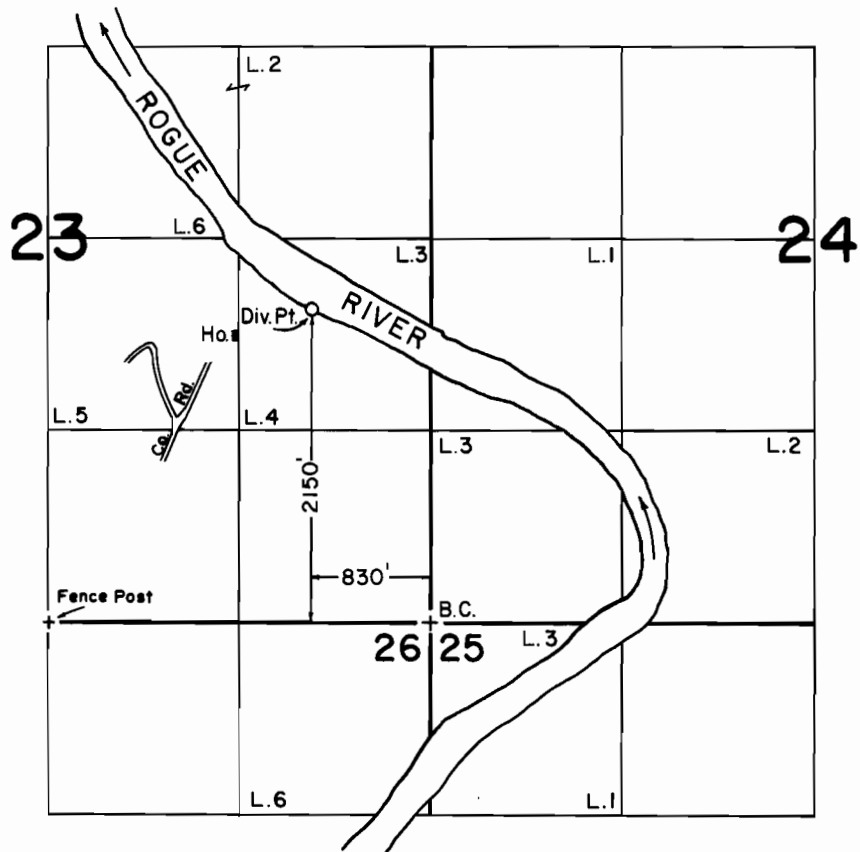

SCALE: 1" = 1320'

FINAL PROOF SURVEY UNDER

Application No. 65231... Permit No. 47880...
IN NAME OF

WAYNE EMERSON TRUAX

Surveyed MAY 17... 1989, by B. S. JAMES.....