


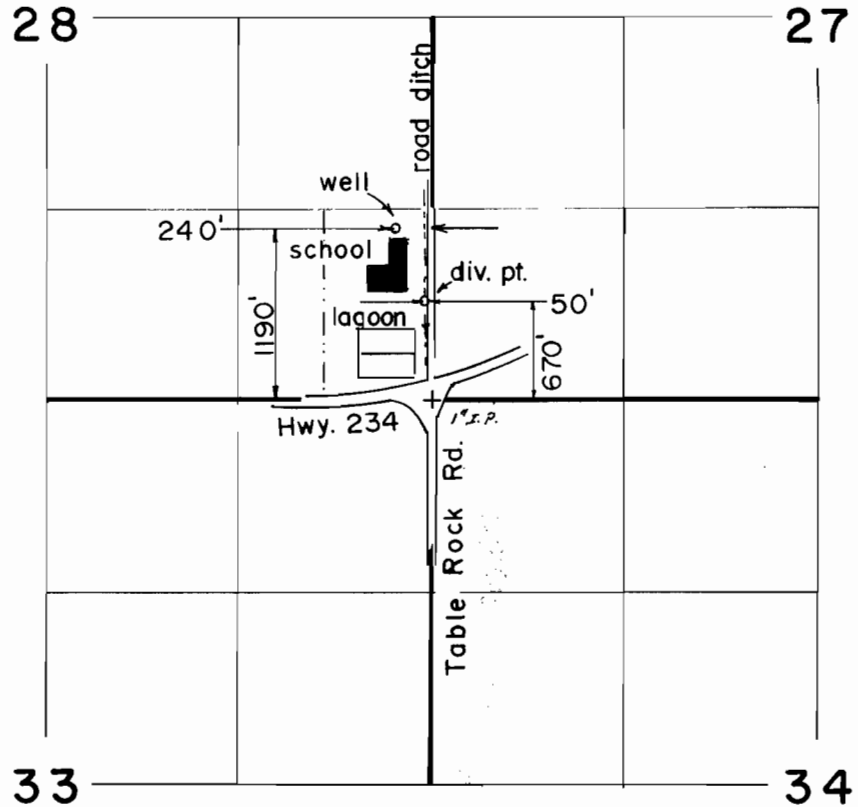

Scale: 1" = 1320'

FINAL PROOF SURVEY

UNDER

G-11405

G-10663

Application No. 68409 Permit No. 49884...

IN NAME OF

SCHOOL DISTRICT 6

Surveyed MAY 12, 1987, by B. S. JAMES.