


T. 32S., R. 3E., W.M.

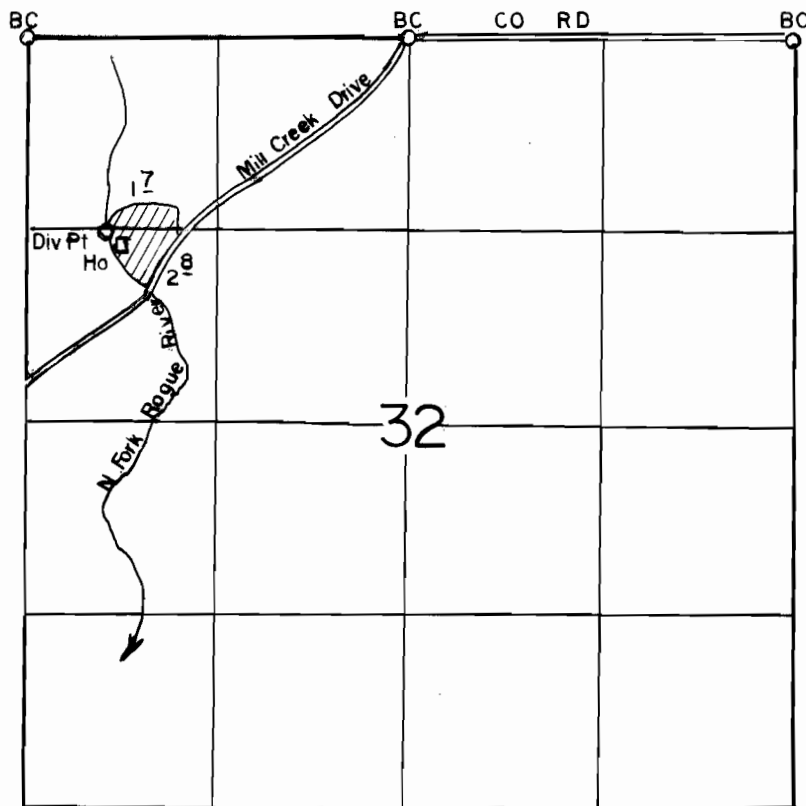

DIV. PT. LOCATED 1350' S & 550' E FROM NW CORNER SECTION 32

SCALE: 1"=1320'

### FINAL PROOF SURVEY UNDER

Application No. 68470... Permit No. 49492.....  
IN NAME OF

.....FRANK & MARIE GLEICH.....

Surveyed JUNE 21... 1989., by B.S. JAMES.....