




T. 34 S., R. 6 W., W.M.

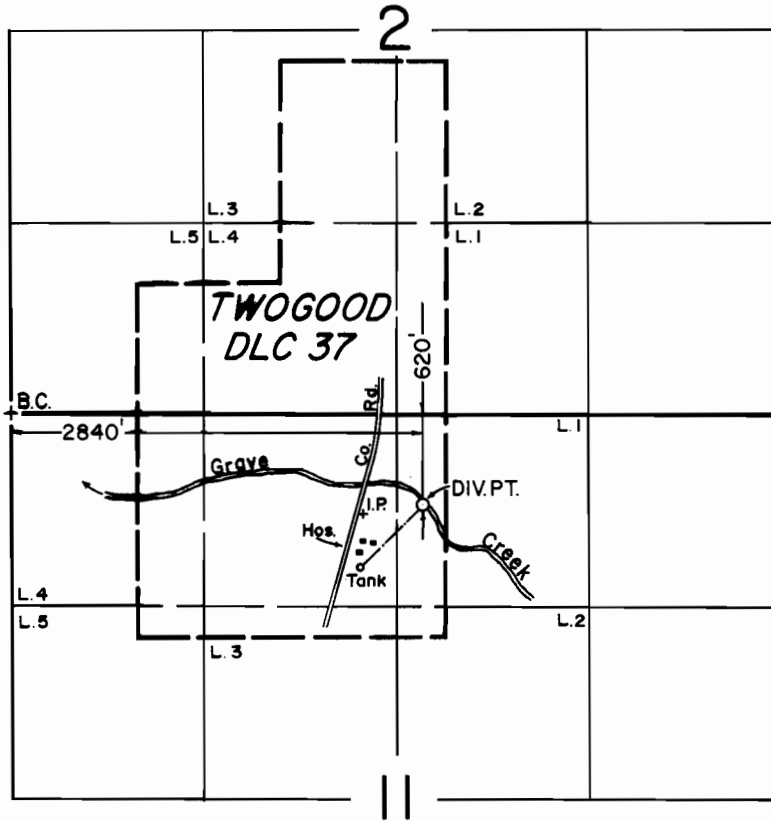

SCALE: 1" = 1320'

FINAL PROOF SURVEY
UNDER

Application No. 68554.. Permit No. 49501.....
IN NAME OF

.....**JOSEPH J. ORRIO**.....

Surveyed **MAY 3** 1989, by **B. S. JAMES**.....