


T. 30S., R. 3W., W.M.

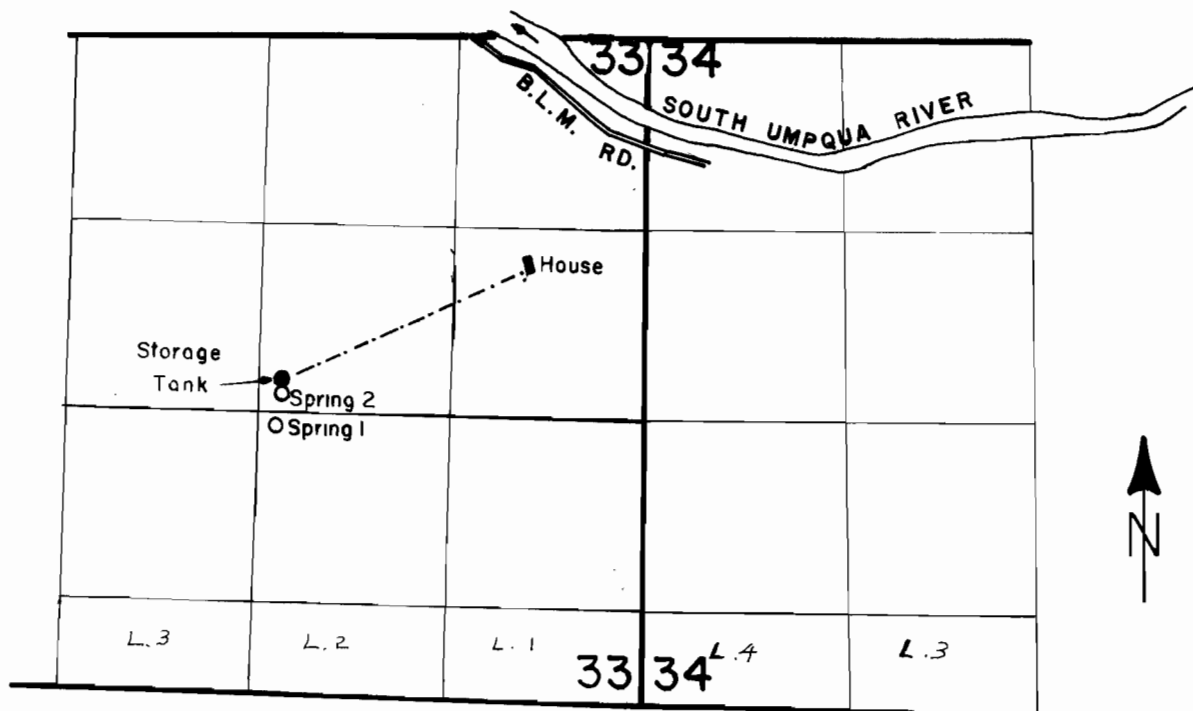

SPRING 1; 75' S. & 125' E. & SPRING 2; 125' N. & 150' E. FROM C1/4 SEC. 33.

SCALE: 4" = 1 MILE

FINAL PROOF SURVEY UNDER

Application No. 68721... Permit No. 49750.....
IN NAME OF

ROBERT D. CONLEY

Surveyed JULY 28, 1987, by J.M. SCHMORDE