


# T. 7 S. R. 2 W. W. M.

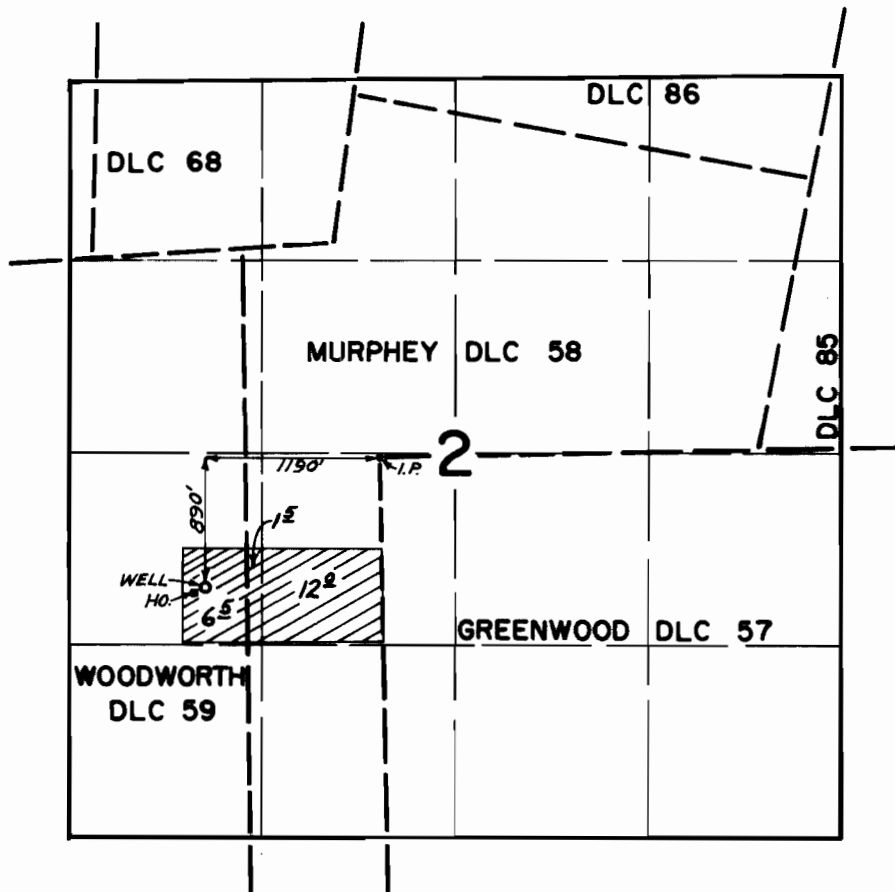

## FINAL PROOF SURVEY UNDER

Application No. ~~G-3250~~ Permit No. ~~G-3707~~  
IN NAME OF

DANIEL HAURY

Surveyed MAY 19 1971, by GREG BACA