


T. 36 S., R. 5 W., W. M.

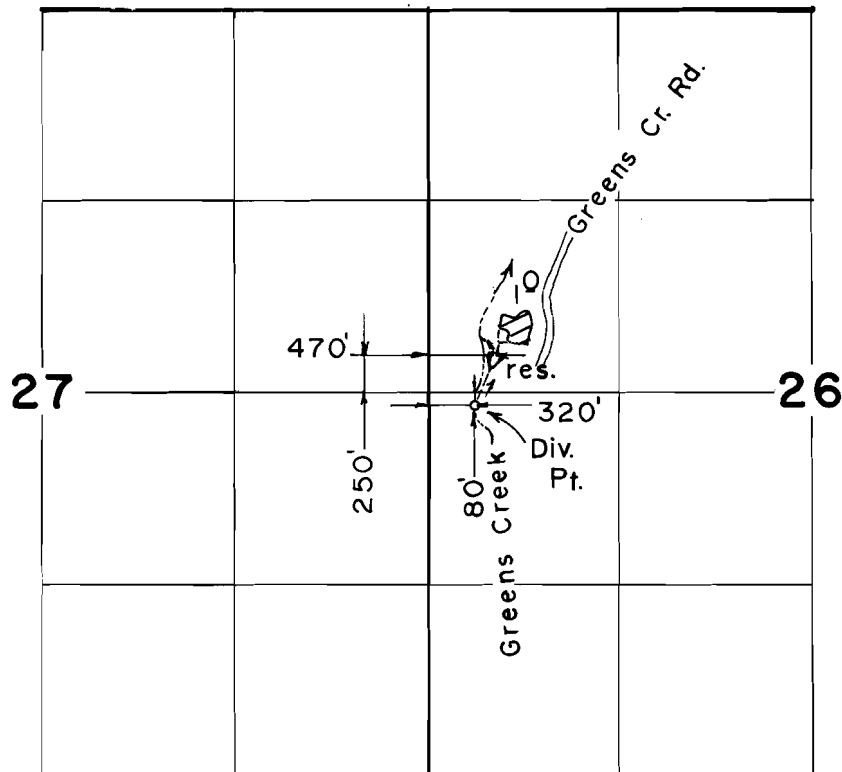

Scale: 1" = 1320'

FINAL PROOF SURVEY

UNDER

R-54750

R-6592

Application No. 54289 Permit No. 41571

IN NAME OF

JESSE A. KASSAHN

Surveyed SEP. 22 19.8.7, by B. S. JAMES...