



T.2N., R.48E., W.M.

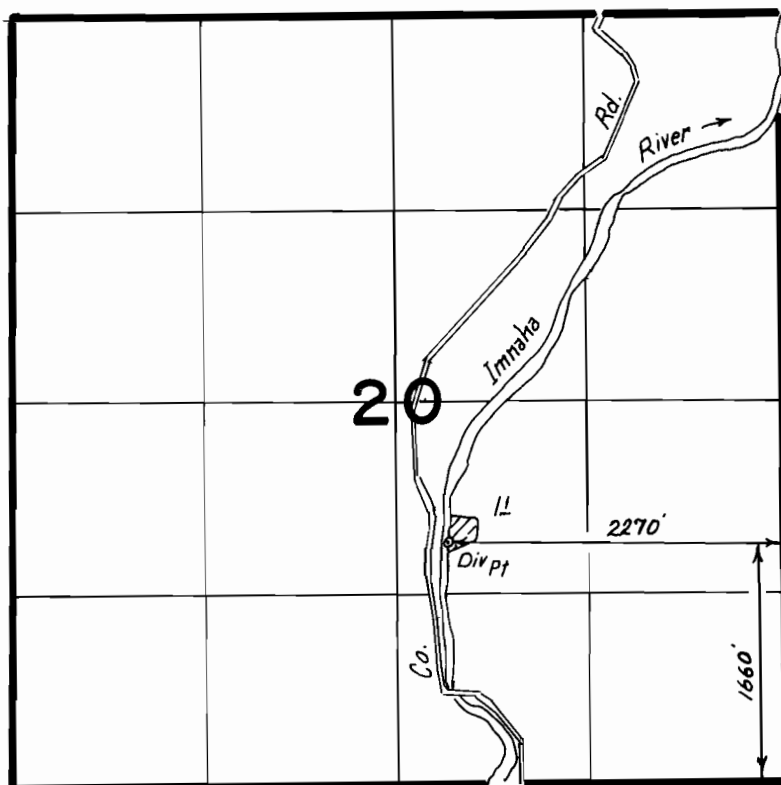

FINAL PROOF SURVEY
UNDER

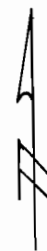

Scale: 1" = 1320'

Application No. 51582 Permit No. 38909
IN NAME OF

CLYDE H. & ROSE SIMMONS

Surveyed 8-7 1985, by Vern Church