


T.26S. R.12W.W.M.

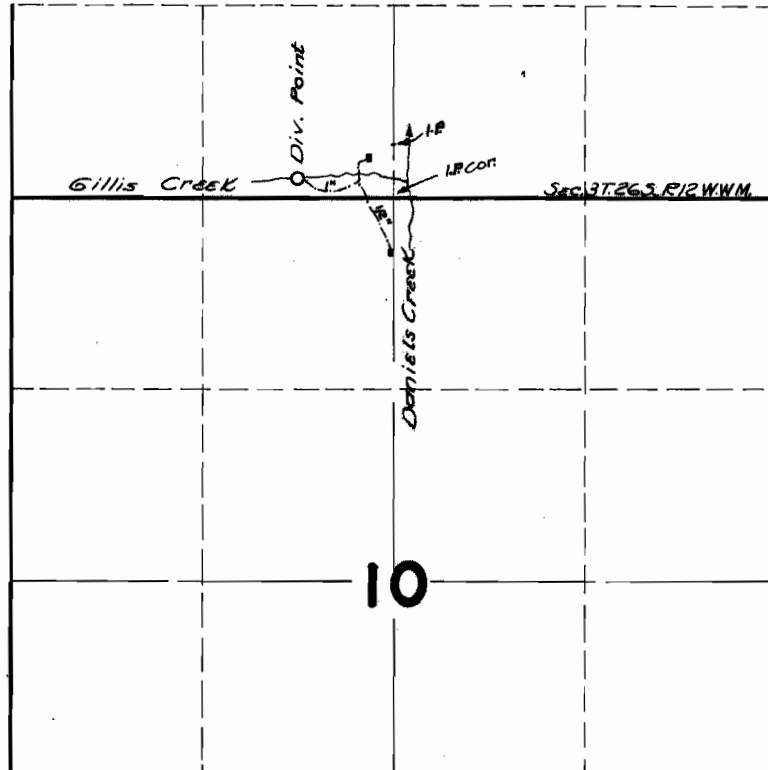

VED 130' N E, 660' W from S. corner Sec 10

FINAL PROOF SURVEY
UNDER

Application No. **22669** Permit No. **17833**
IN NAME OF

JOHN M. GILLIS AND NATHAN CUTLIP

Surveyed **AUG. 30 1949**, by **H.L. COFFMAN**.