


# BUREAU OF LAND MANAGEMENT ANDY RESERVOIR

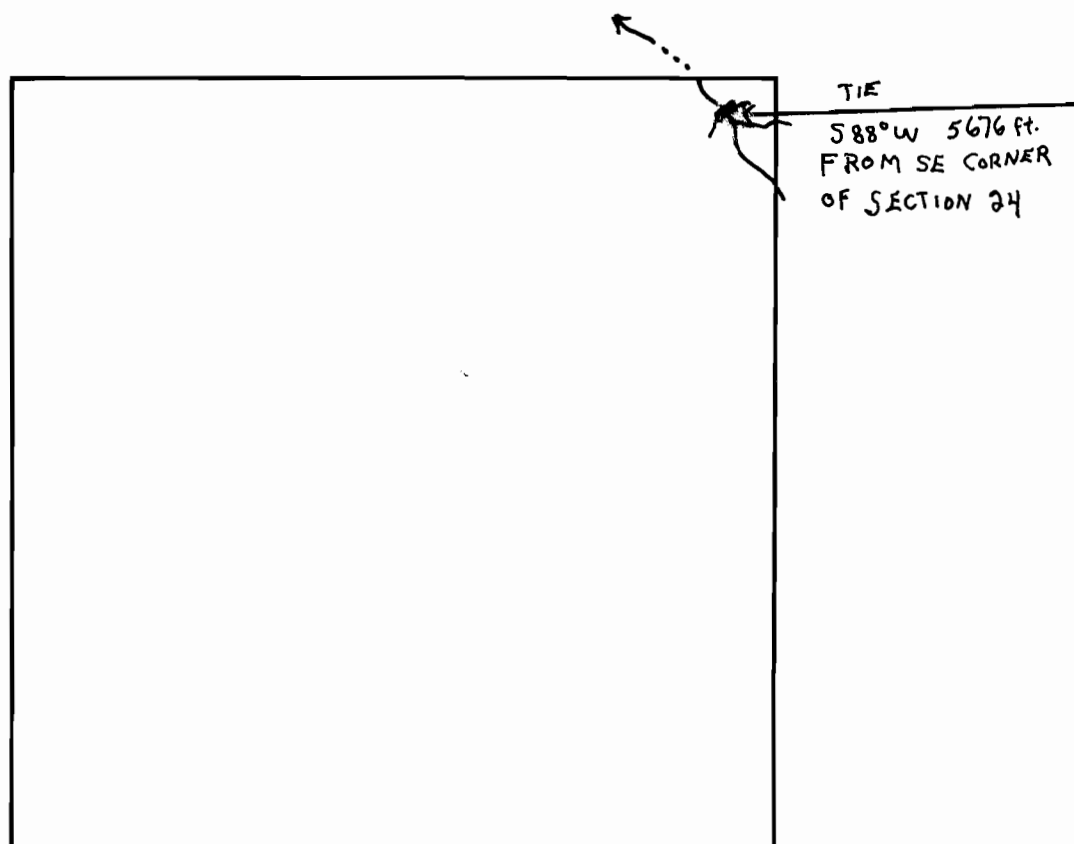

T38S; R23 E; SEC 26 WM.

PROJECT -   
INTERMITTENT STREAM 

Acres No. R-33718  
Project No. R-2346

Lam  
2/60