
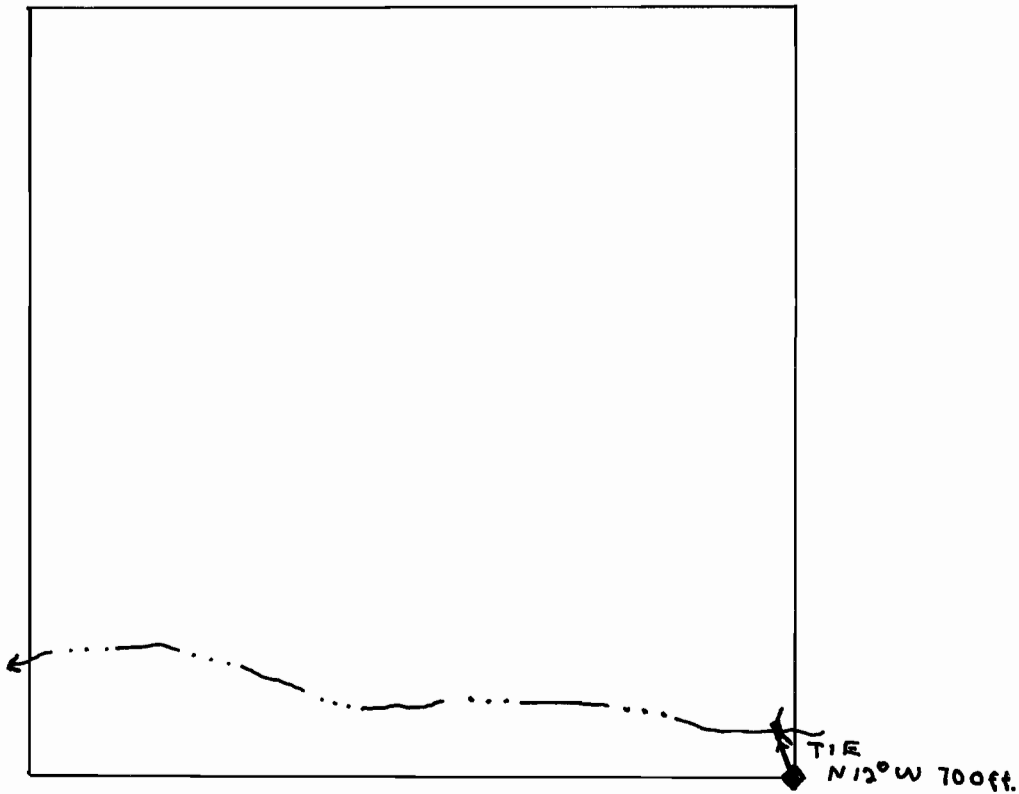


BUREAU OF LAND MANAGEMENT
SWEENEY RESERVOIR

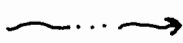

T39S; R23E; SEC. 1 WM.

PROJECT - 

INTERMITTENT STREAM 

FOUND SURVEY CORNERS 

Application No. R-33719
Permit No. R-2347

JdM
2/60