

UNITED STATES
DEPARTMENT OF THE INTERIOR
BUREAU OF LAND MANAGEMENT

SECTION


Oregon State Water Filings

28

TOWNSHIP 20 S., RANGE 29 E., W. M. 02-439

North

28

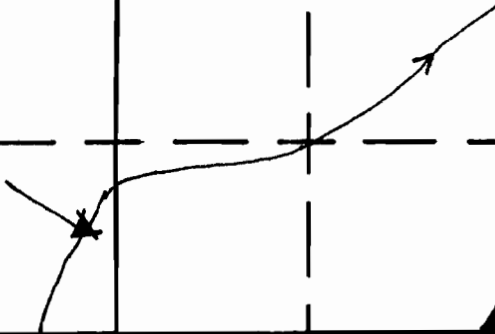

Application No.
Permit No.

R-33785
R-2377

South

APPLICATION No.
PERMIT No.