


UNITED STATES
DEPARTMENT OF THE INTERIOR
BUREAU OF LAND MANAGEMENT

SECTION _____
Oregon State Water Filings

_____ 14 _____
TOWNSHIP 30 S., RANGE 30 E., W. M.

02-1091

North

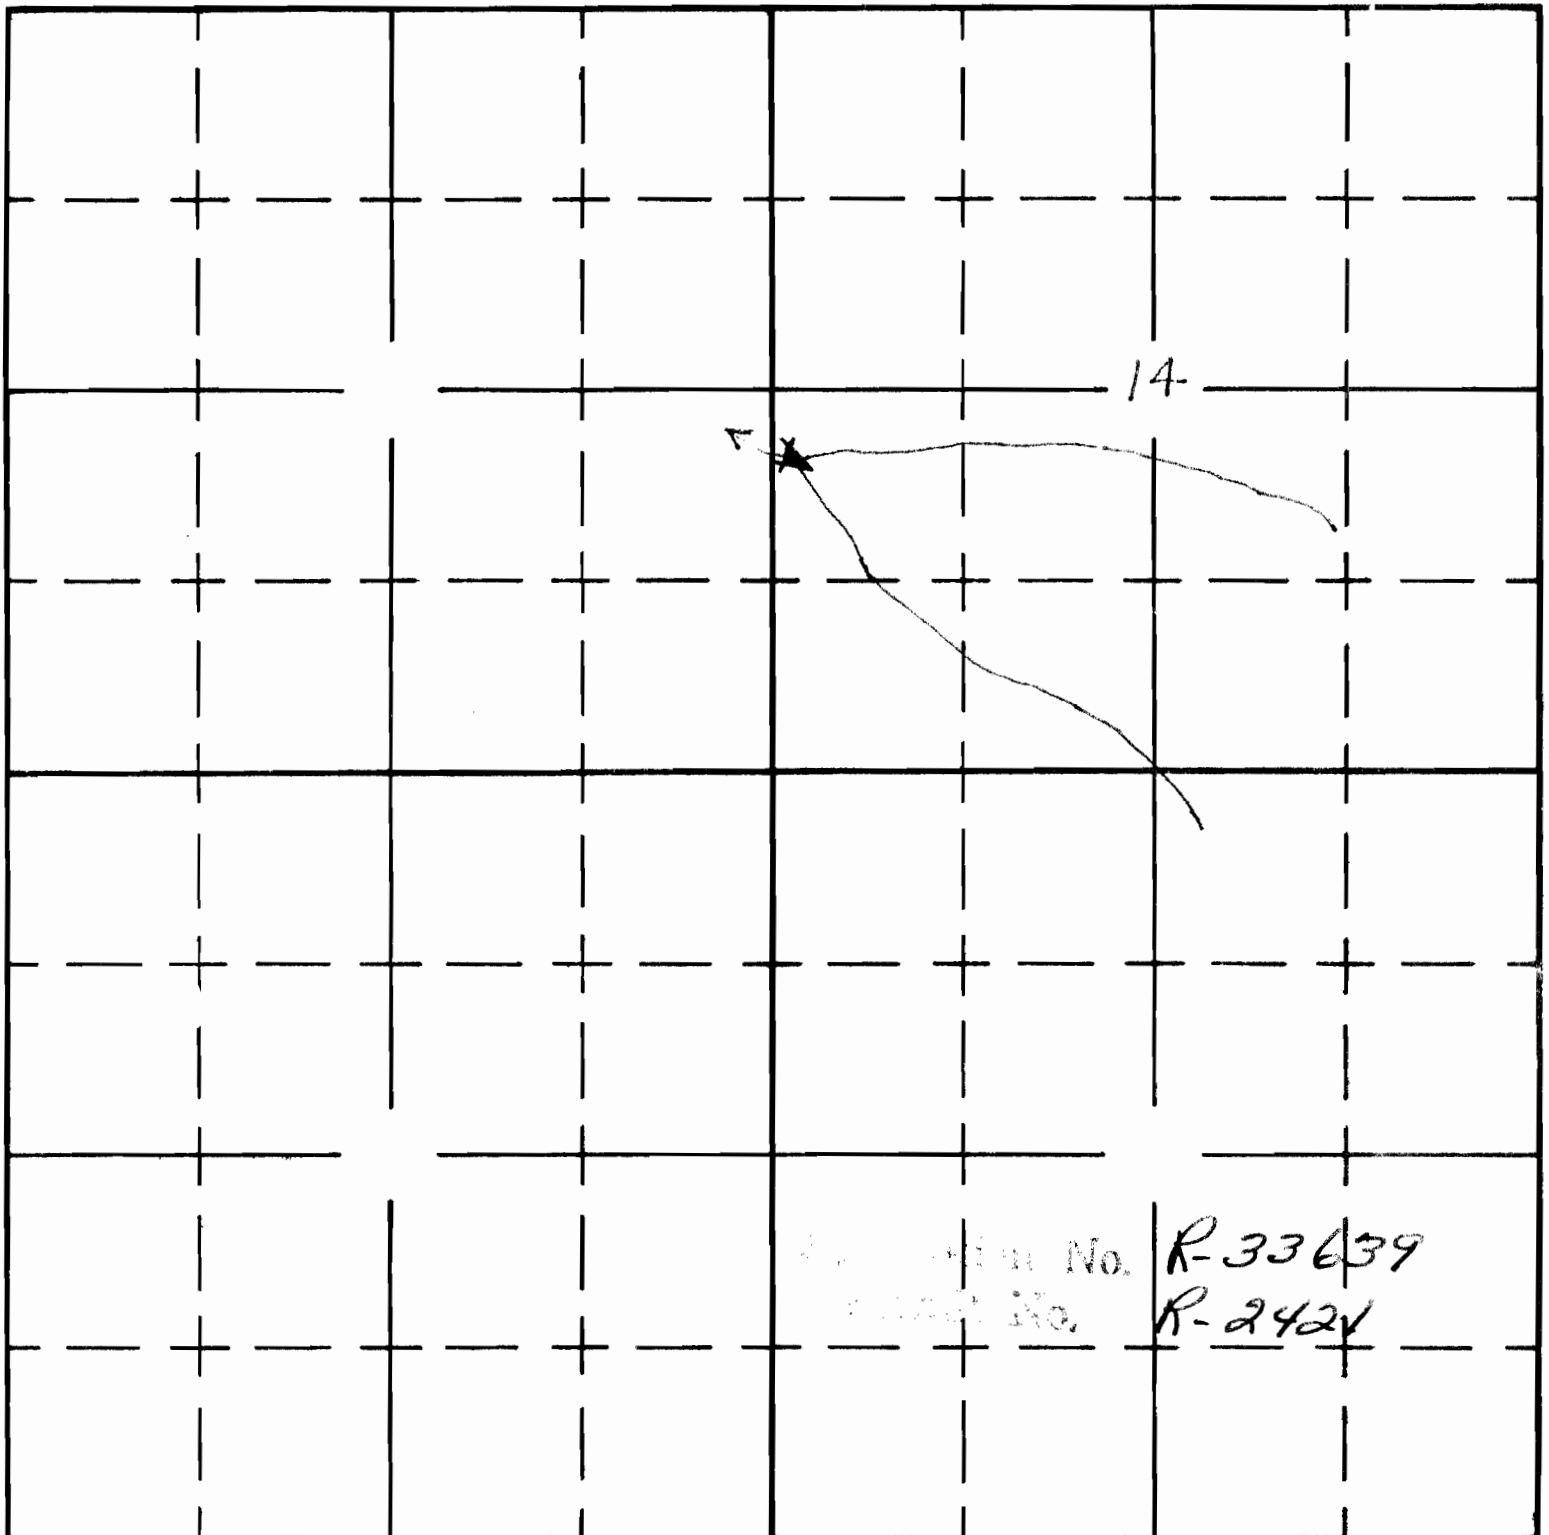

Nearest found corner
NE corner section 12

South

APPLICATION No.

PERMIT No.