

UNITED STATES
DEPARTMENT OF THE INTERIOR
BUREAU OF LAND MANAGEMENT


SECTION

28
S $\frac{1}{2}$ NW $\frac{1}{4}$

Oregon State Water Filings

TOWNSHIP 23 S, RANGE 24 E, W. M.

North

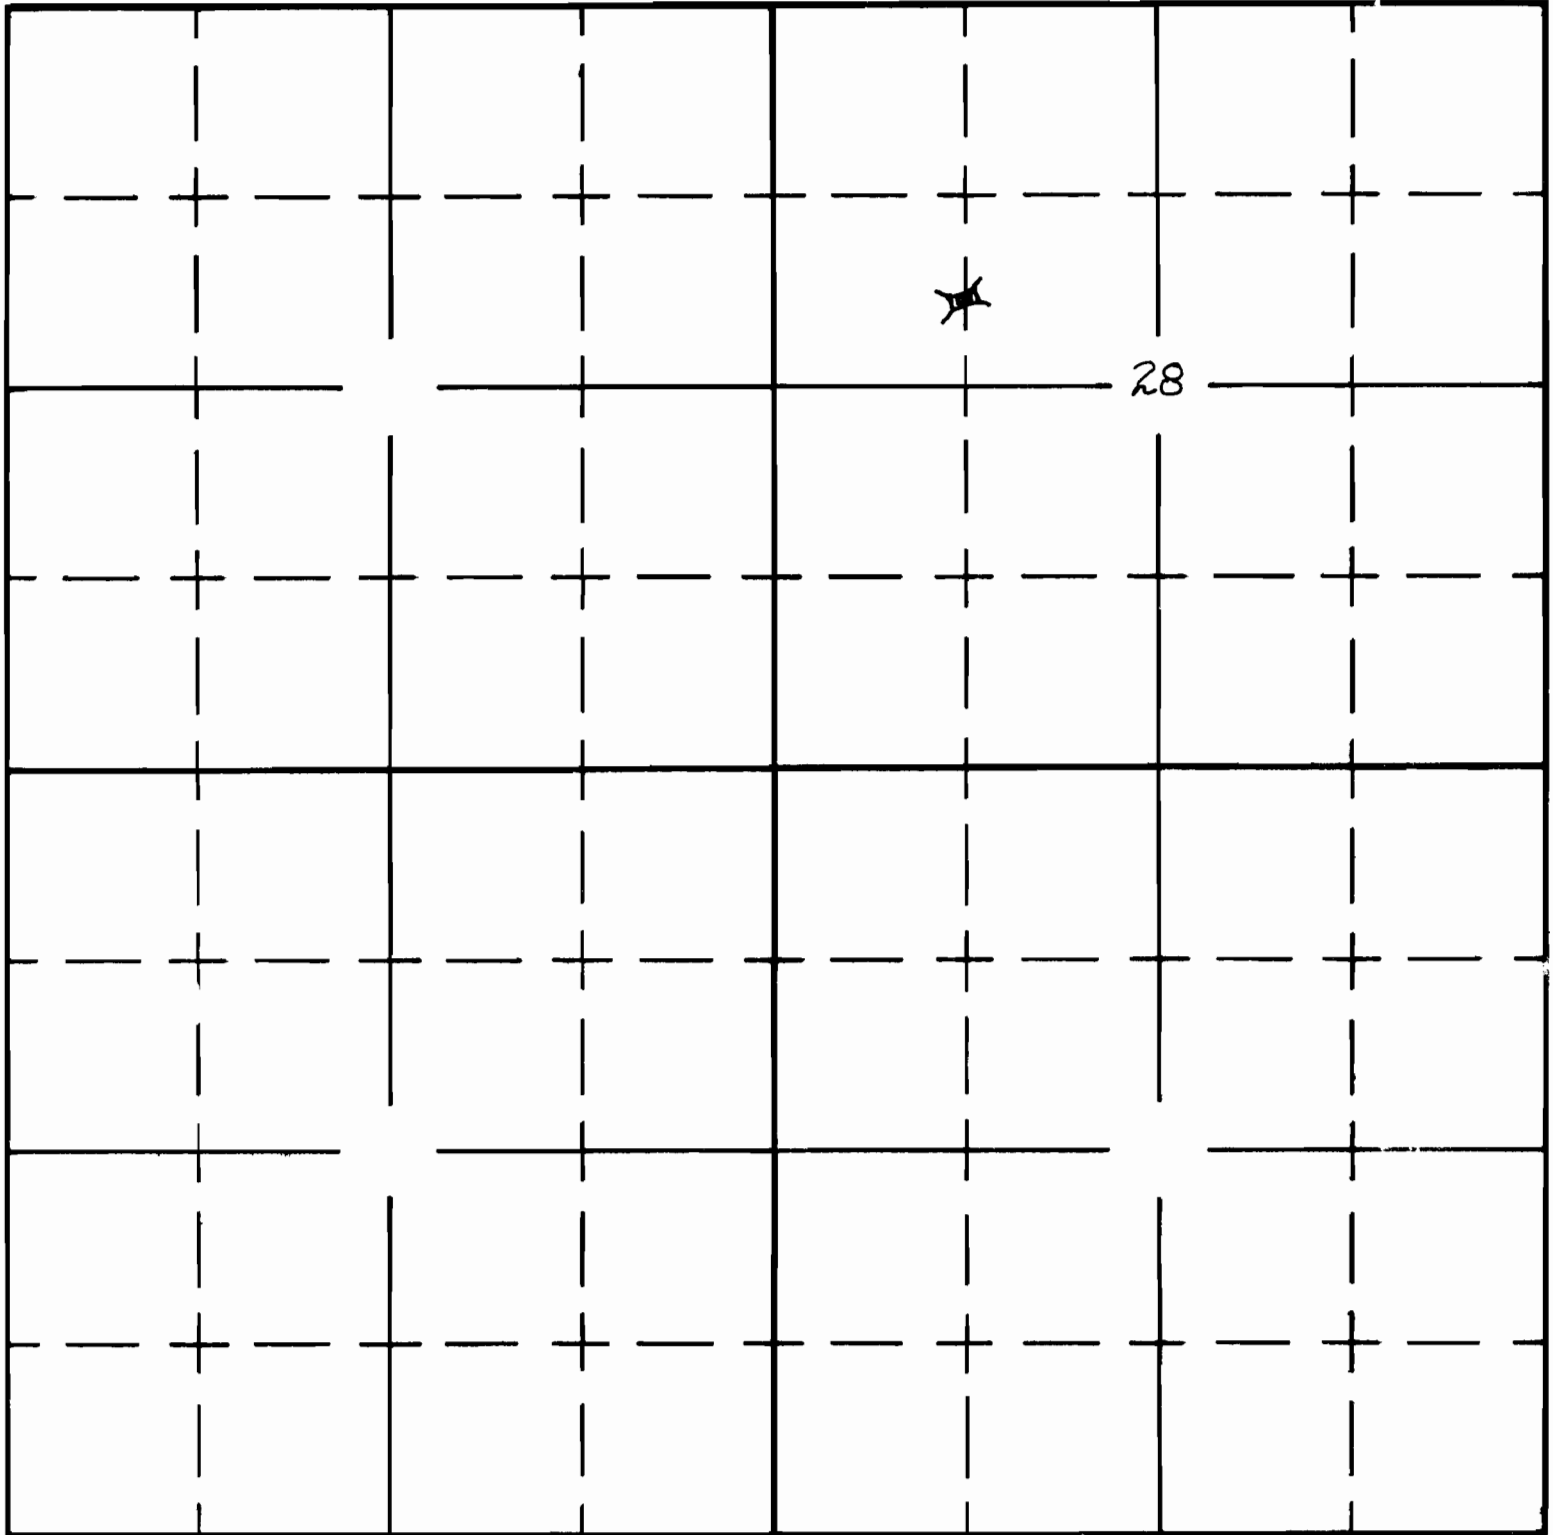

Application No. R-34323
Permit No. R-2500

APPLICATION No.
PERMIT No.