

UNITED STATES
DEPARTMENT OF THE INTERIOR
BUREAU OF LAND MANAGEMENT

SECTION


27

SW $\frac{1}{4}$ SE $\frac{1}{4}$

Oregon State Water Filings

TOWNSHIP 22, RANGE 24, W. M.

North

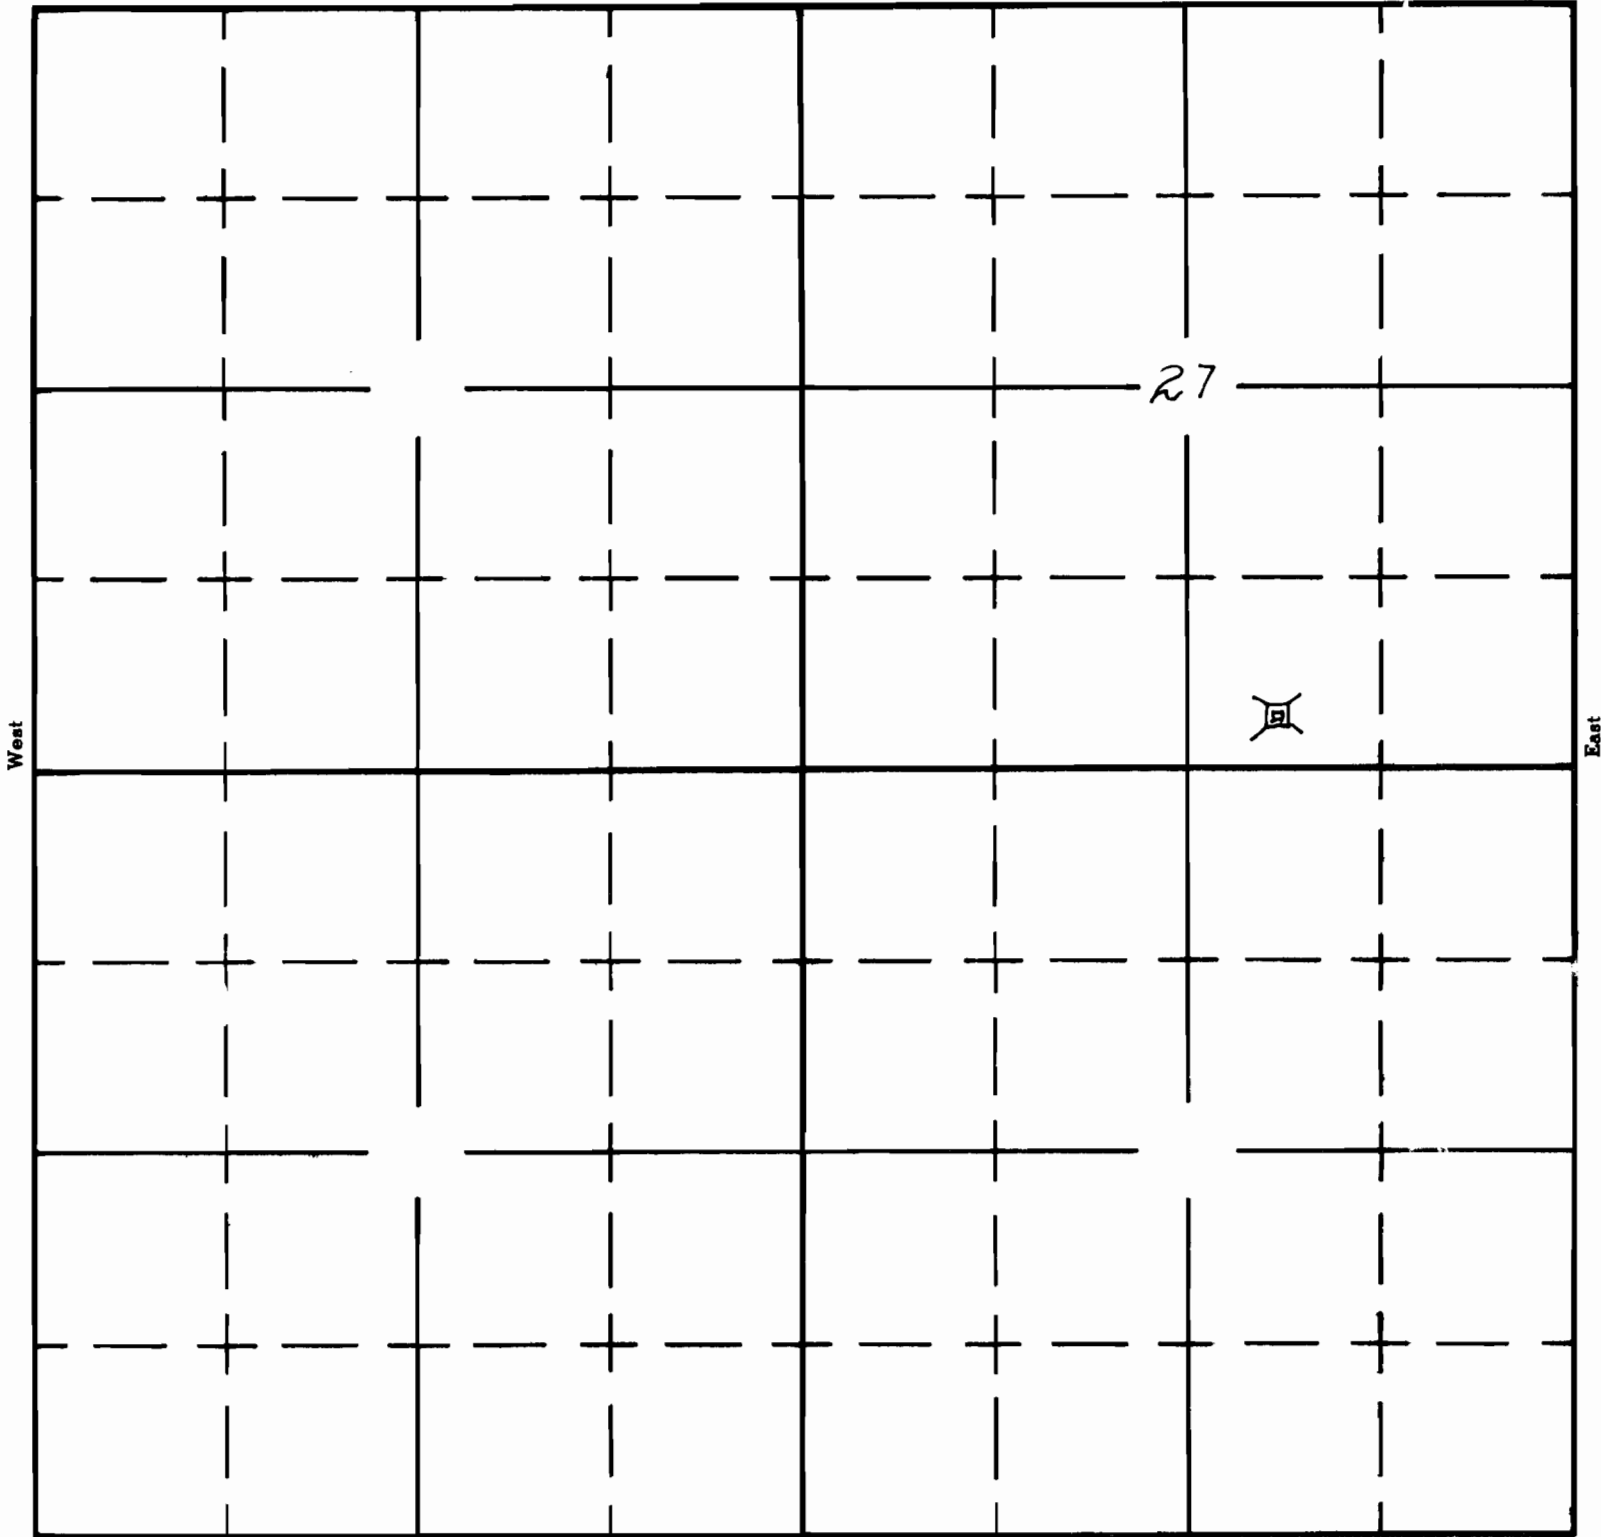

South

Application No. R-34325
Permit No. R-2502

APPLICATION No.
PERMIT No.