



Oregon State Water Filings

SECTION

34
NW 1/4 SE 1/4

TOWNSHIP 22, RANGE 24, W. M.

North

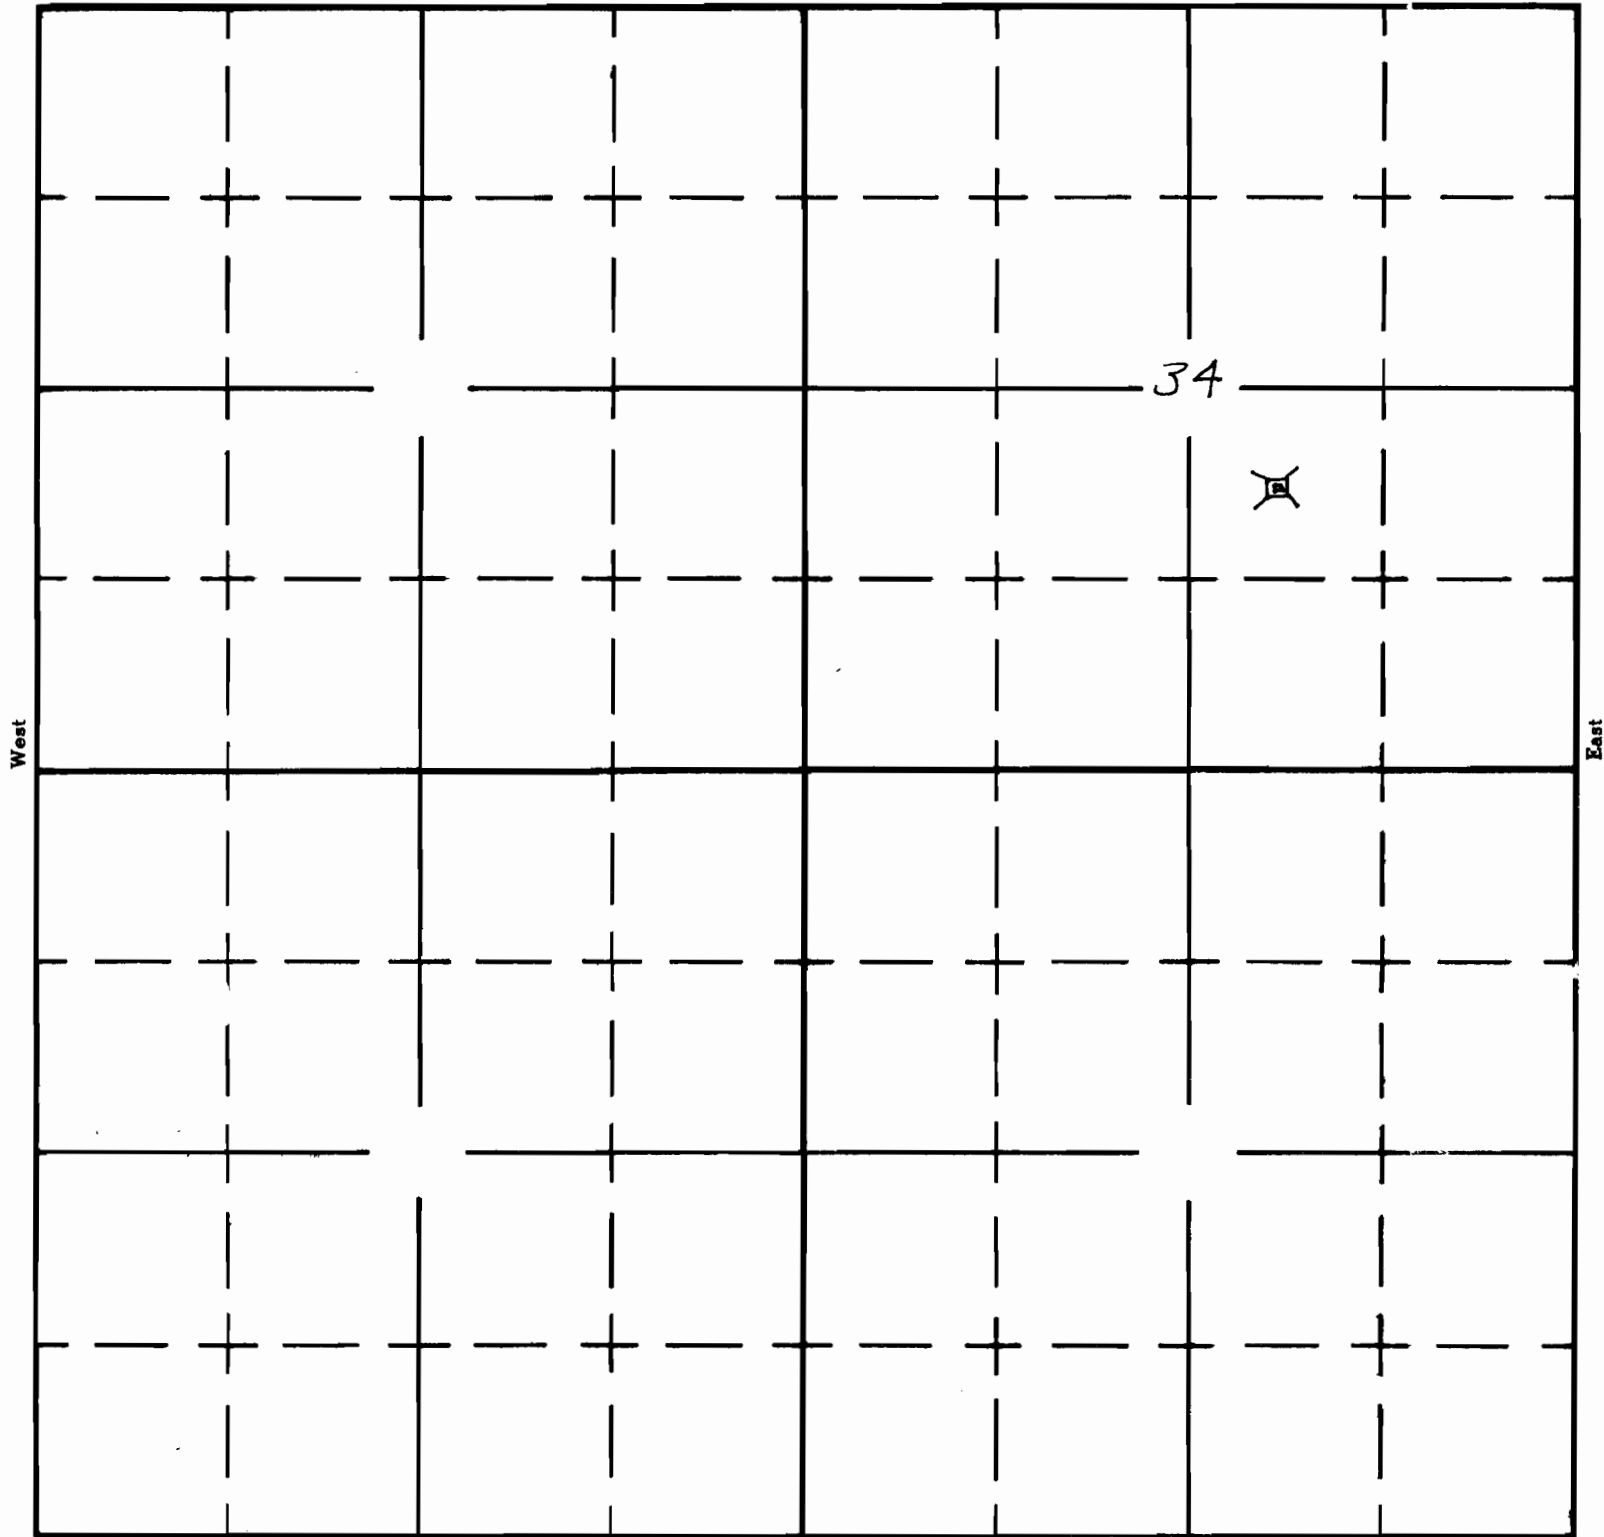

South

Application No. R-34326

Permit No. R-2573

APPLICATION No.

PERMIT No.