

UNITED STATES  
DEPARTMENT OF THE INTERIOR  
BUREAU OF LAND MANAGEMENT

SECTION


34

NW 1/4 SW 1/4

# Oregon State Water Filings

TOWNSHIP 22 S, RANGE 24 E, W. M.

North

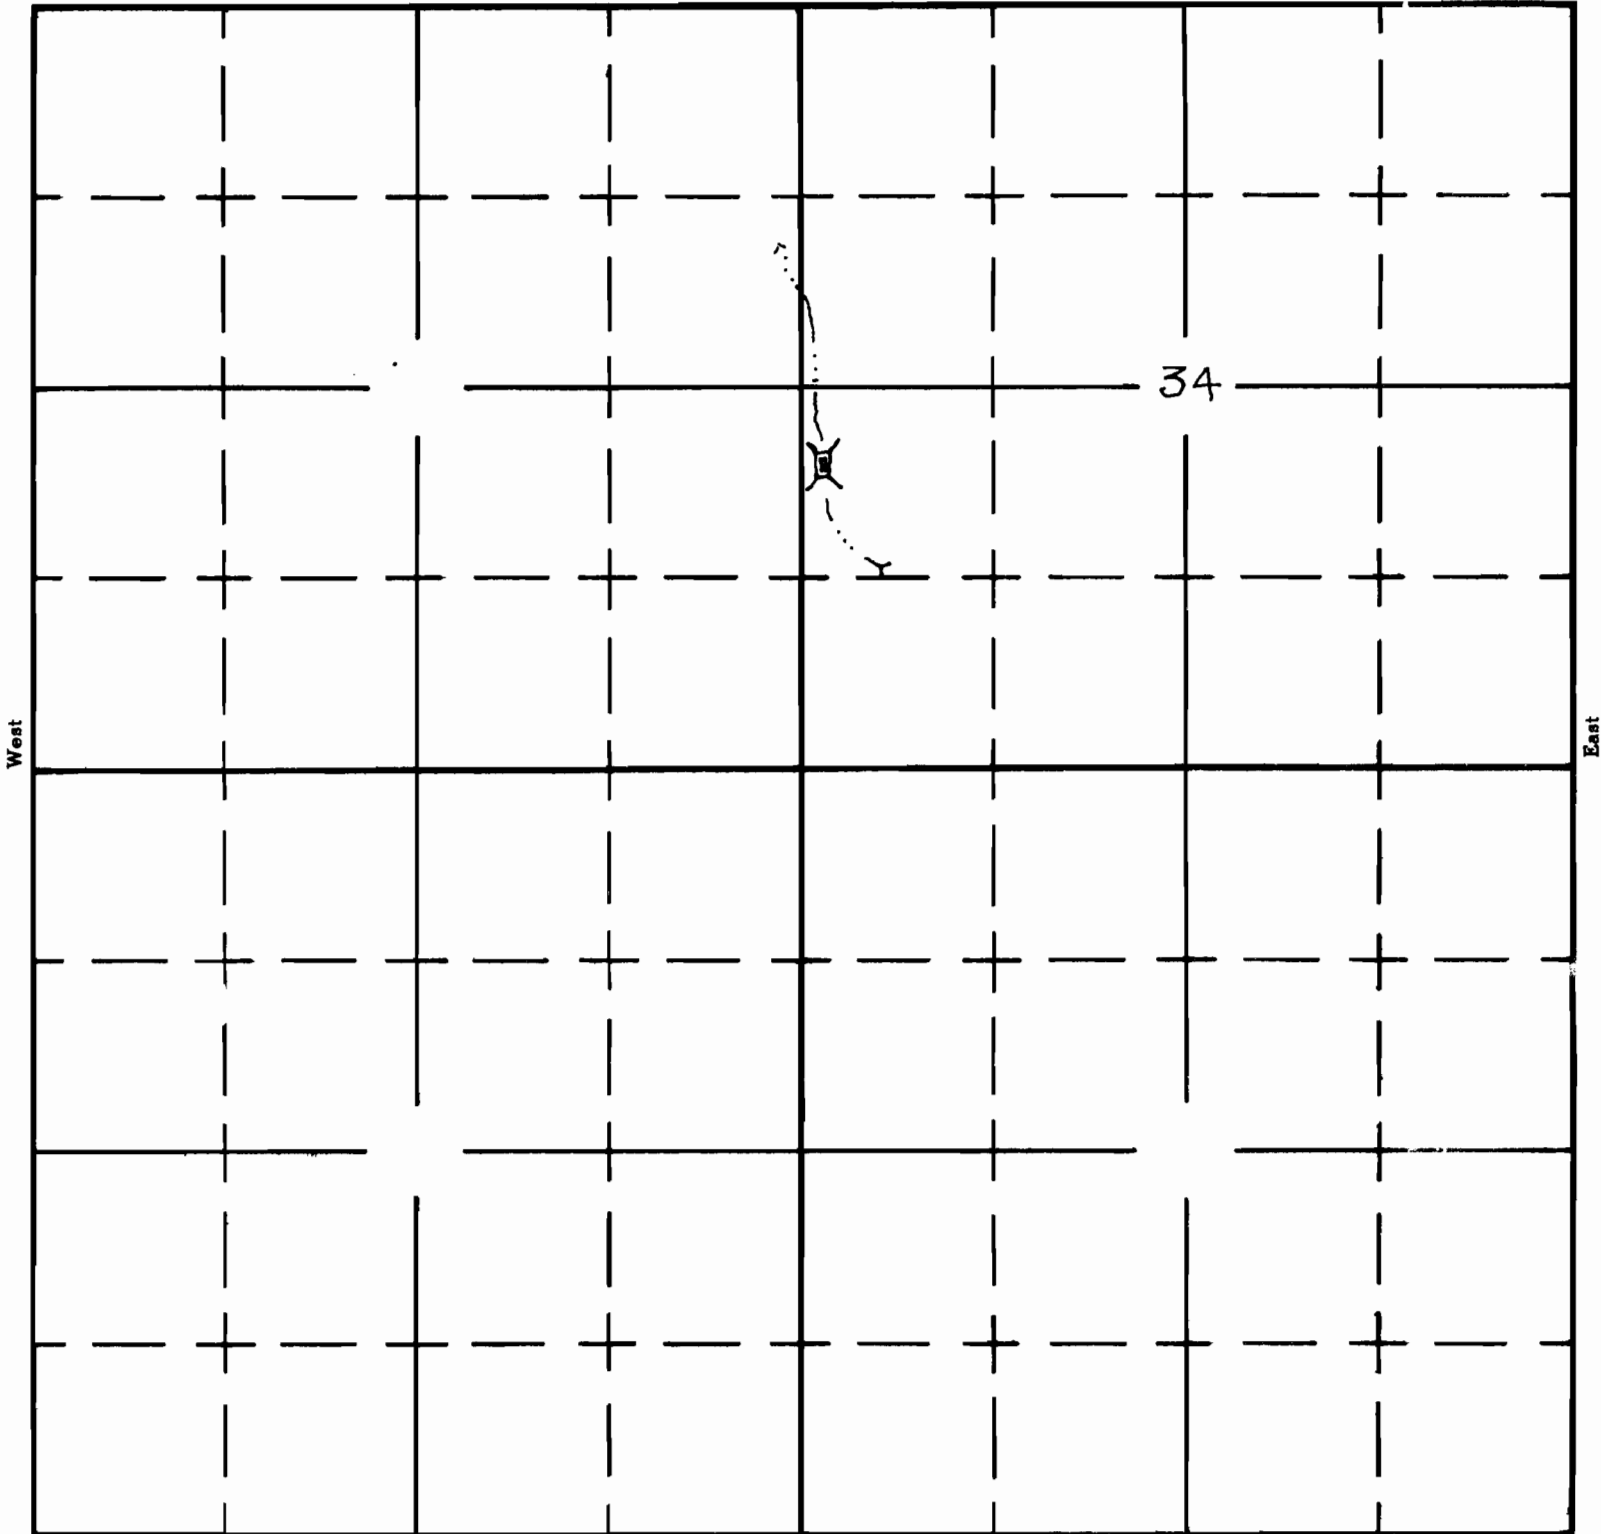

Application No. R-34327  
Permit No. R-2504

APPLICATION No.  
PERMIT No.