

UNITED STATES
DEPARTMENT OF THE INTERIOR
BUREAU OF LAND MANAGEMENT


SECTION

30
NE $\frac{1}{4}$ SE $\frac{1}{4}$

Oregon State Water Filings

TOWNSHIP 22 S, RANGE 25 E, W. M.

North

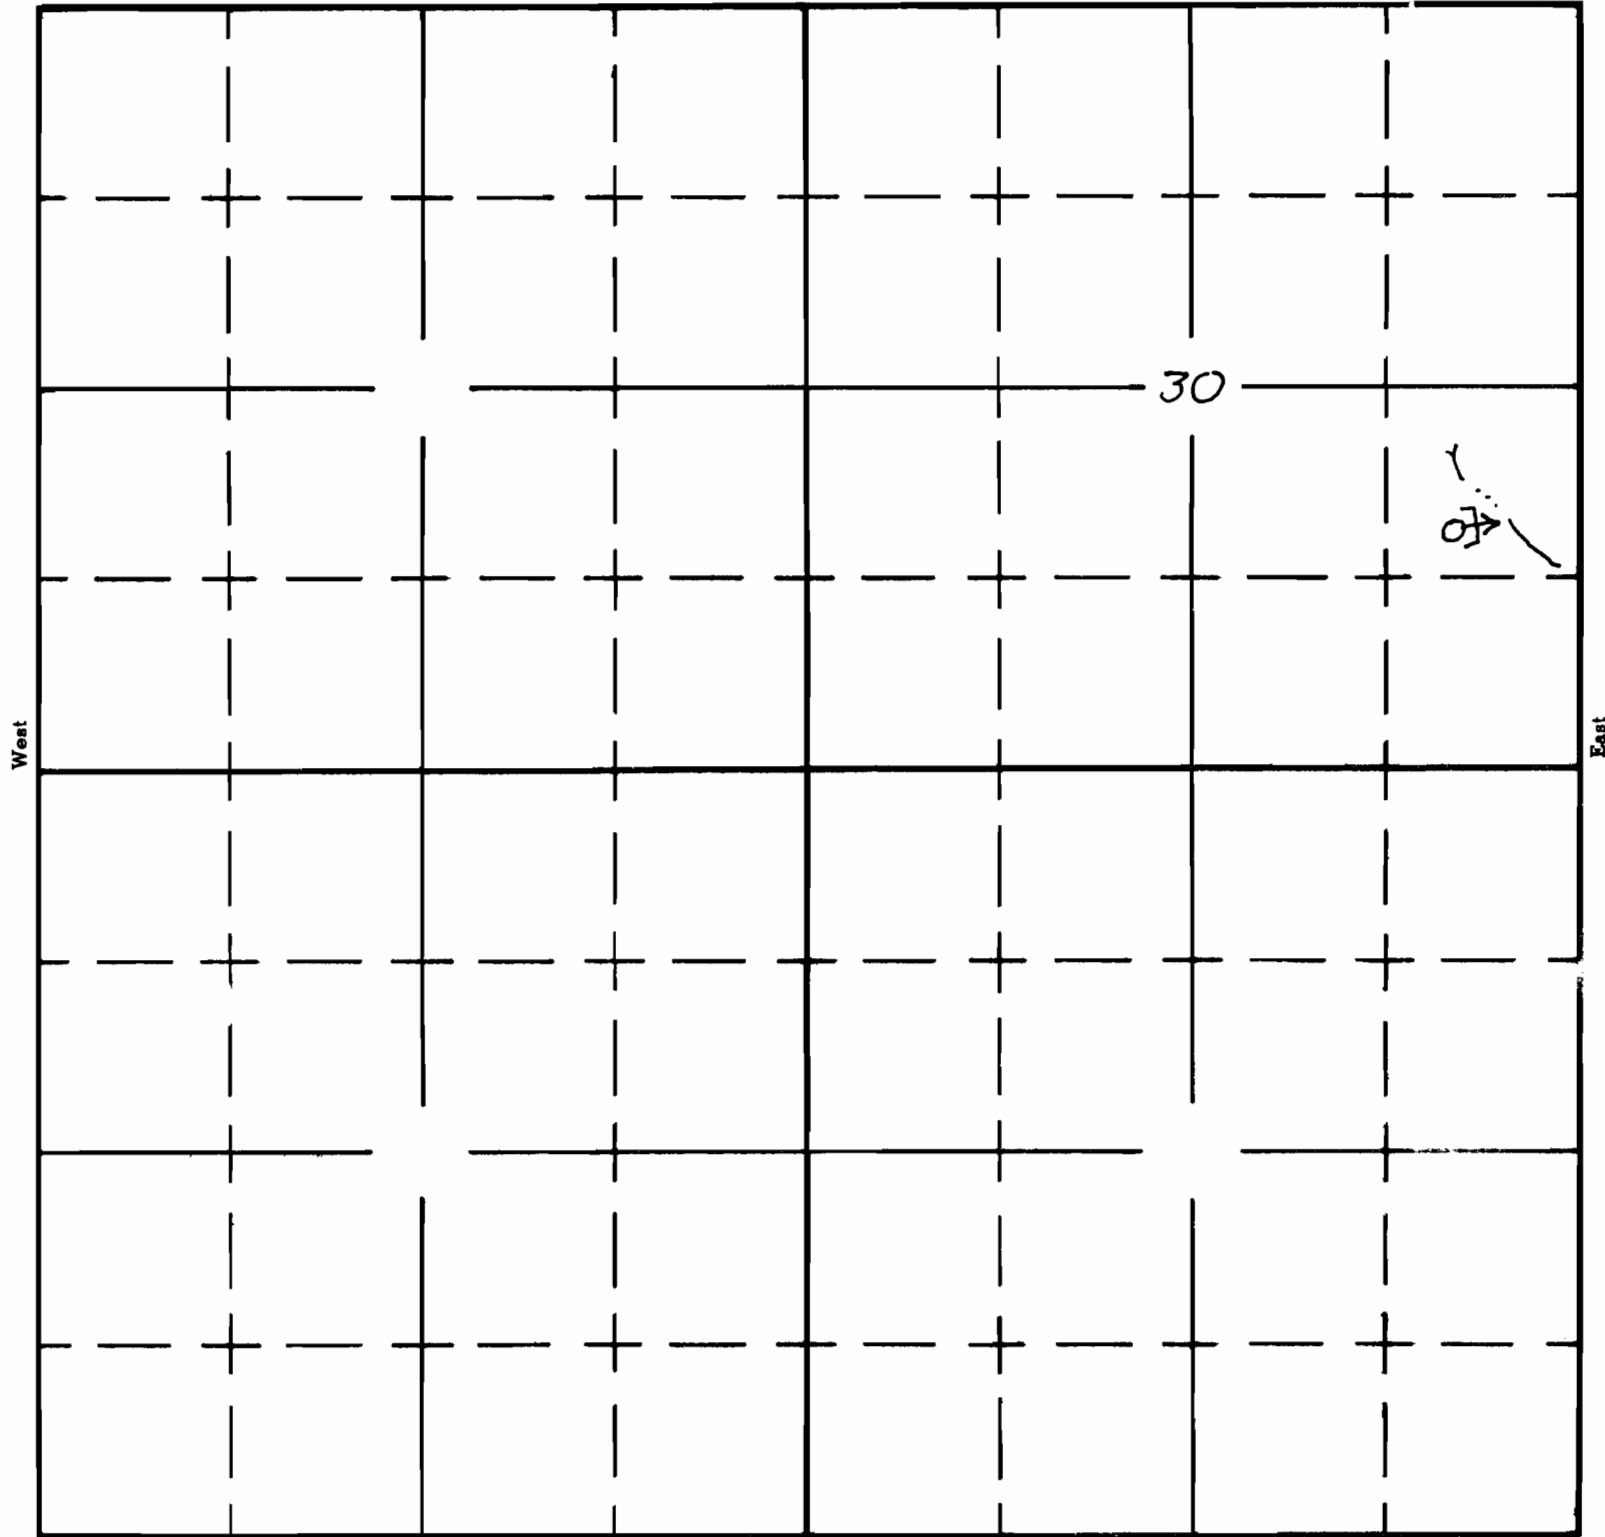

South

Application No. R-34328
Permit No. R-2505

APPLICATION No.
PERMIT No.