


UNITED STATES
DEPARTMENT OF THE INTERIOR
BUREAU OF LAND MANAGEMENT

SECTION
29
NW $\frac{1}{4}$ NE $\frac{1}{4}$

Oregon State Water Filings

TOWNSHIP 22 S., RANGE 25 E., W. M.

North

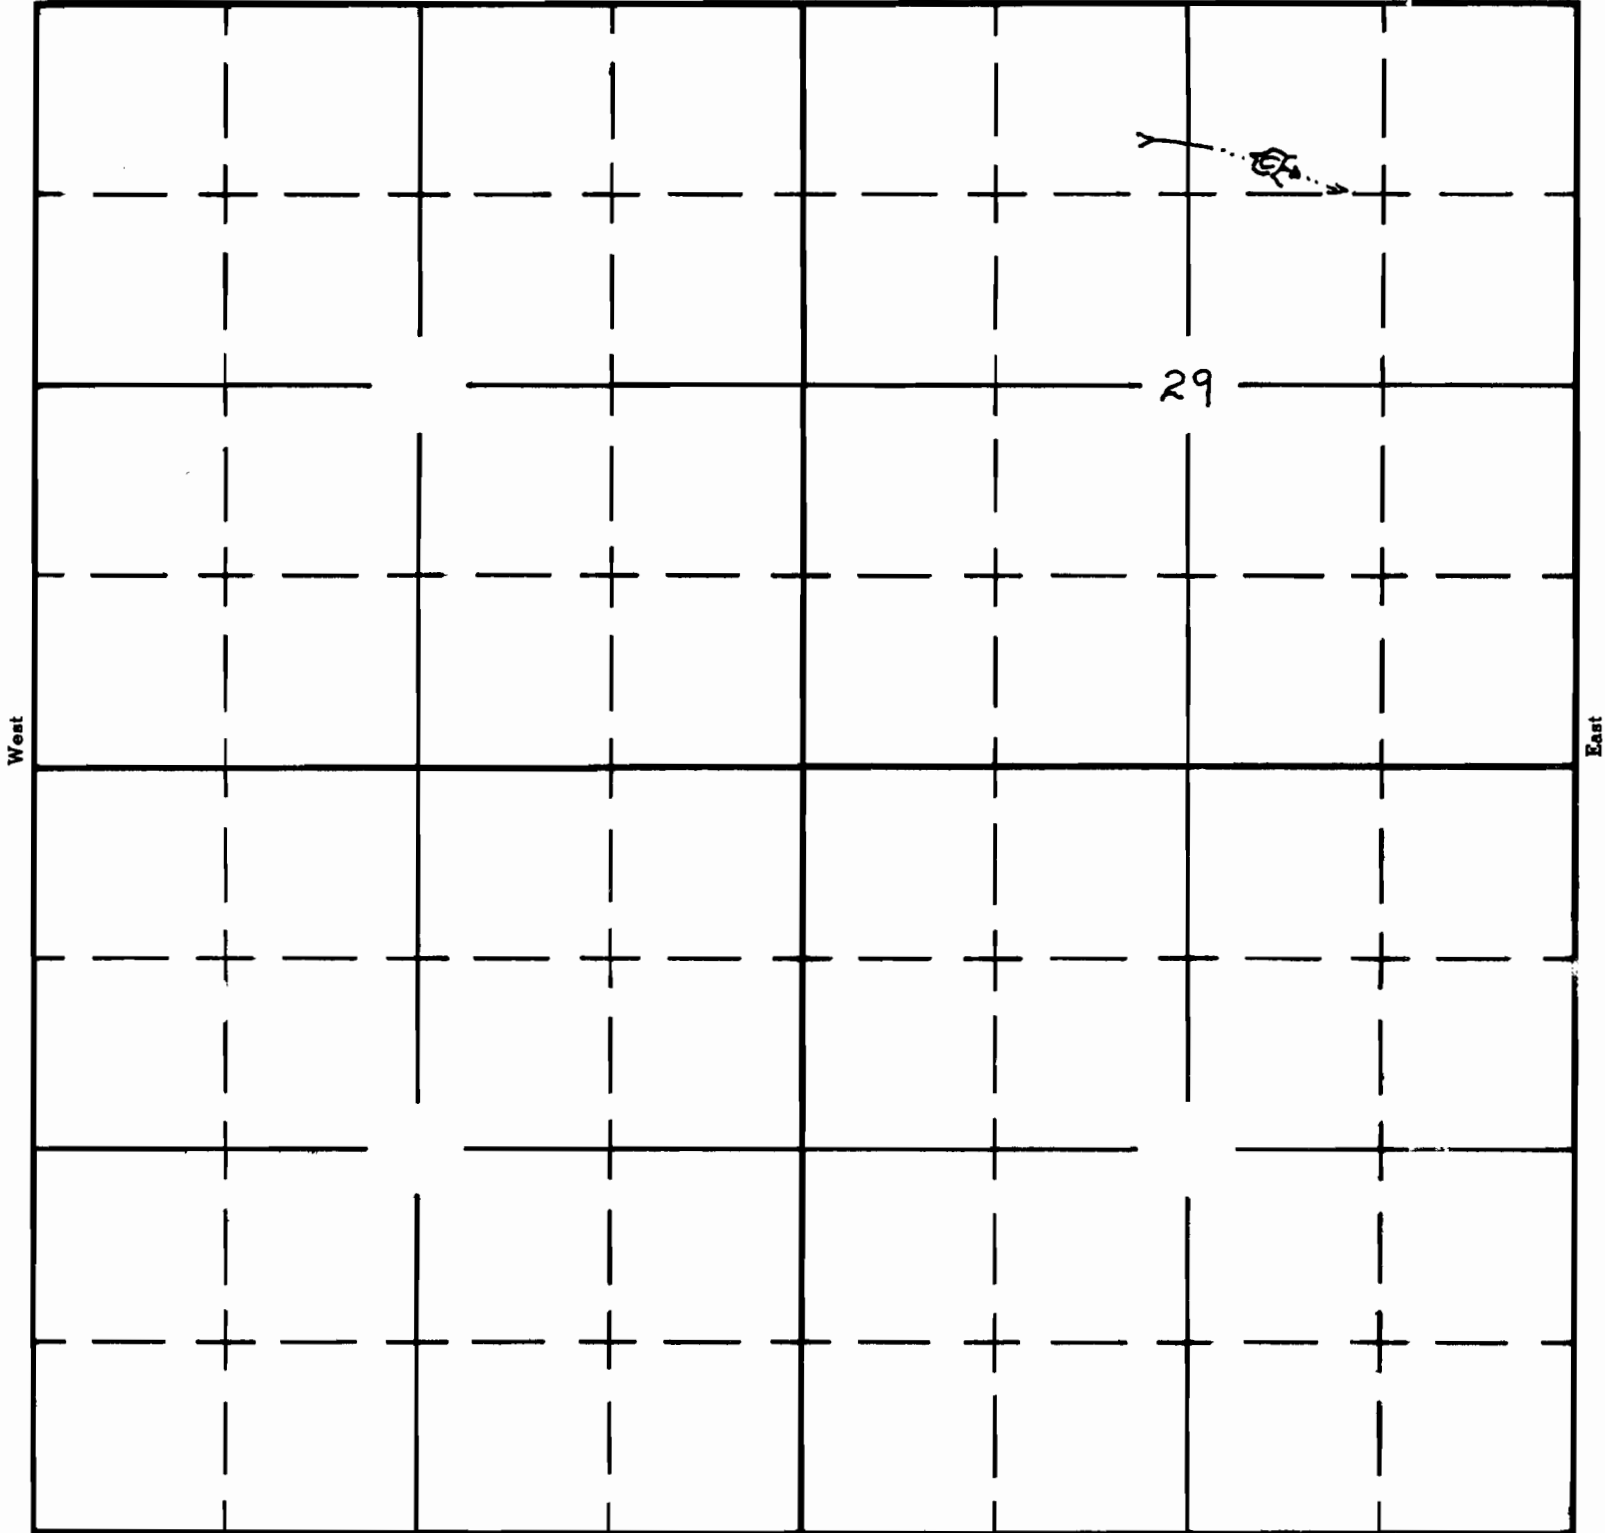

Section No. ^{South} R-34329
Permit No. R-2506

APPLICATION No.
PERMIT No.