


UNITED STATES
DEPARTMENT OF THE INTERIOR
BUREAU OF LAND MANAGEMENT

SECTION

8
NW 1/4 NW 1/4

Oregon State Water Filings

TOWNSHIP 23 S, RANGE 24 E, W. M.

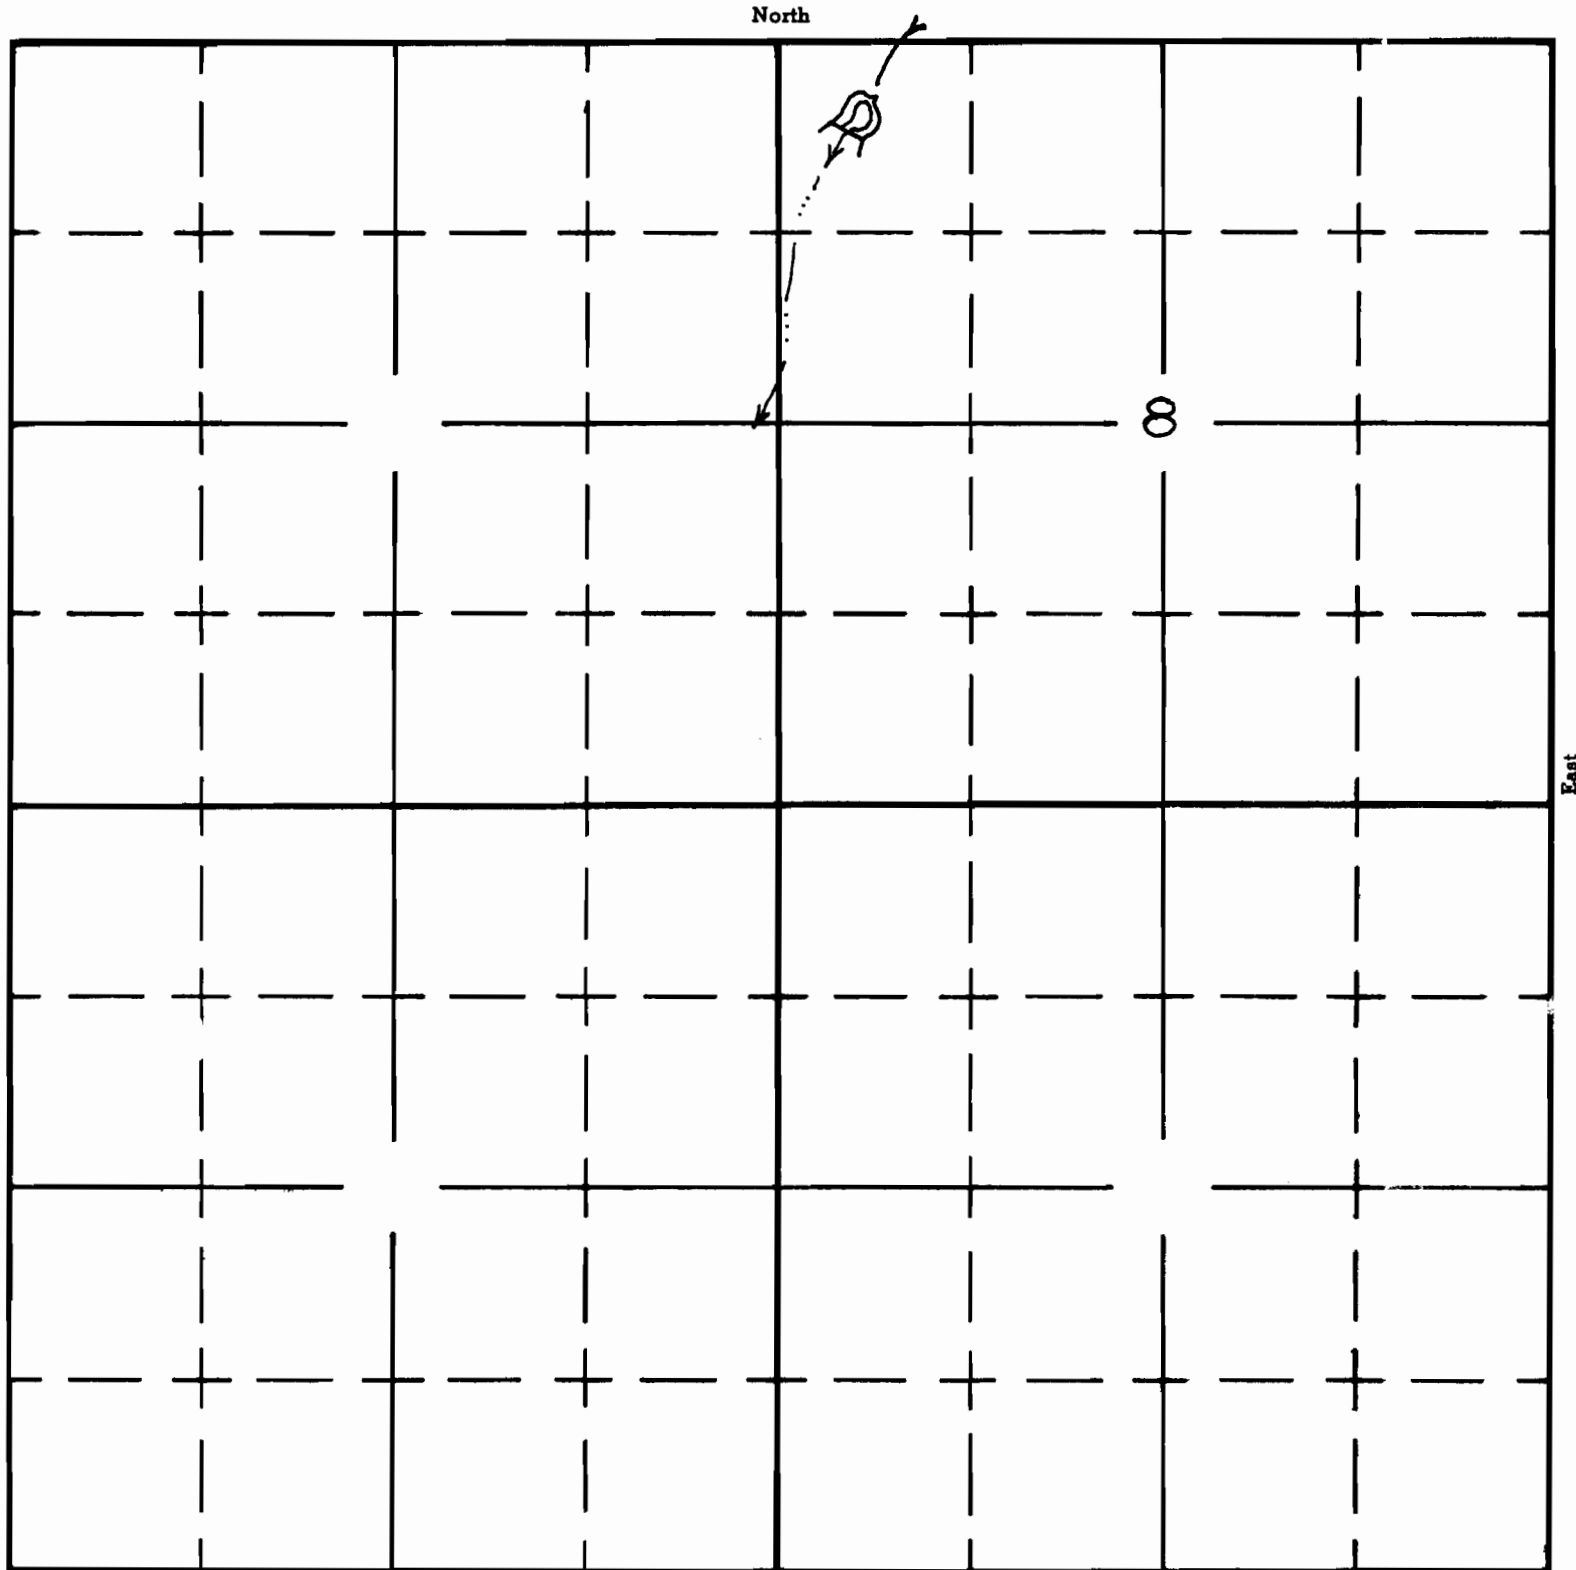

Application No. R-34330
Permit No. R-2507

APPLICATION No.
PERMIT No.