

UNITED STATES
DEPARTMENT OF THE INTERIOR
BUREAU OF LAND MANAGEMENT


SECTION

* 25

Oregon State Water Filings

PARKS PLACE
RESERVOIR.

TOWNSHIP 23S., RANGE 37E., W. M.

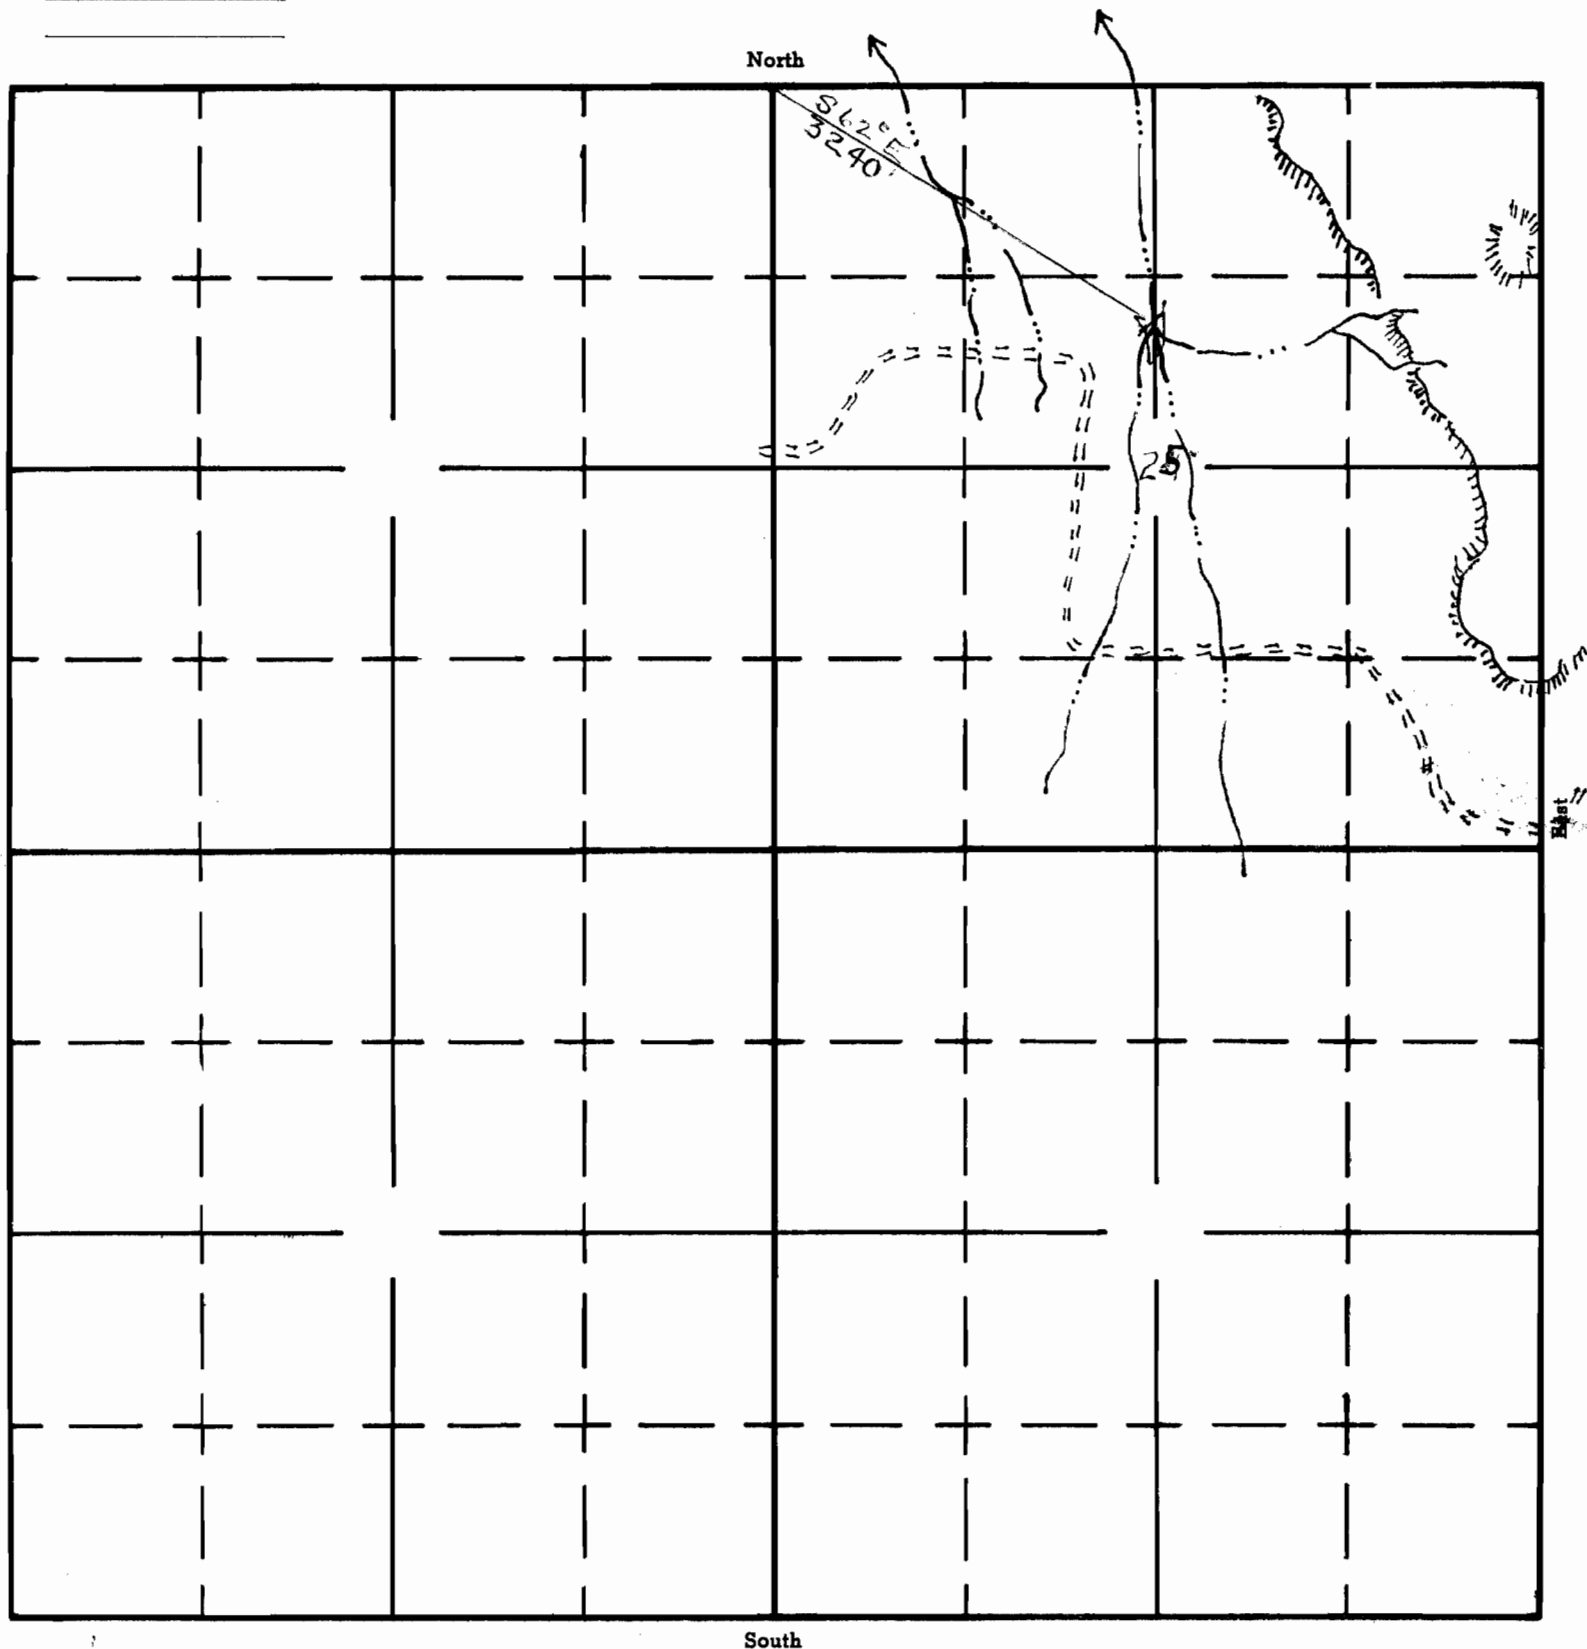

APPLICATION No. R-34383
PERMIT No. R-2551