


R-2070
62768

BUREAU OF LAND MANAGEMENT TWENTY ONE DAM

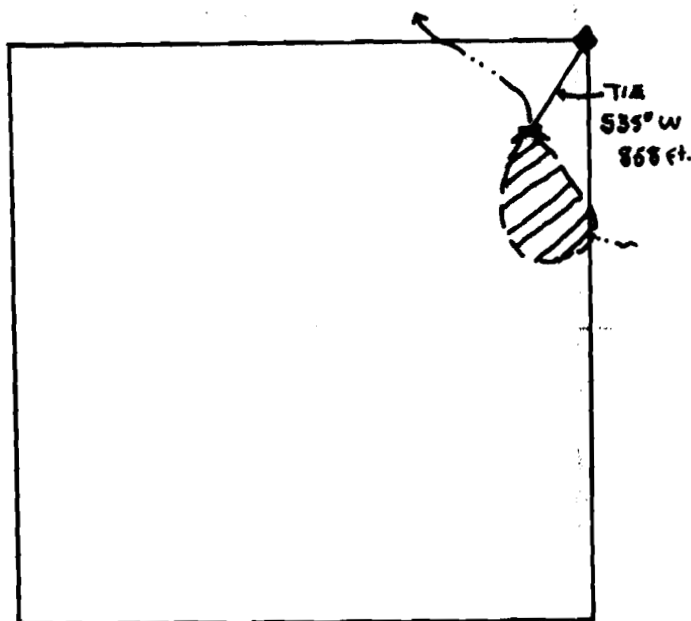

T40S; R14E; SEC. 21, WM.

PROJECT - 

INTERMITTENT STREAM 

FOUND SURVEY CORNERS 

STATE ENGINEER
SALEM, OREGON

Application No. R-23722
Permit No. R-2598

Lam
2/60

E. Be. Lost. Rv. of Miss.