


R-2604
62769

BUREAU OF LAND MANAGEMENT SPREADER WATERHOLE

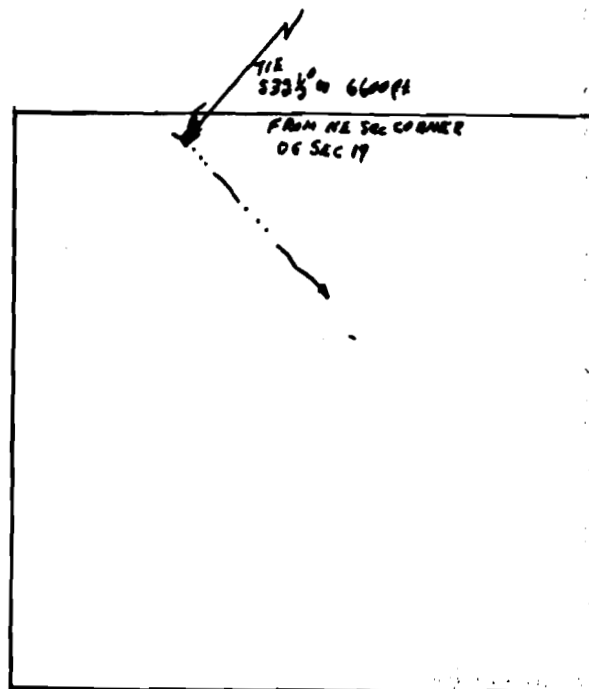

T40S; R14 1/2 E; SEC 20 WM

PROJECT- W

INTERMITTENT STREAM ~~~~~>

RECEIVED
MAY 11 1960
STATE ENGINEER

ARM
3/60

Application No. R-33729
Permit No. R-2604

E. Be. Lost Riv. & Miss.