


RECEIVED
Bureau of
Land Management
Lakeview, Ore.
APR 1960
SECTION _____
TOWNSHIP _____
RANGE _____

UNITED STATES
DEPARTMENT OF THE INTERIOR
BUREAU OF LAND MANAGEMENT

Oregon State Water Filings

TOWNSHIP 4/S, RANGE 14/E, W. M.

North

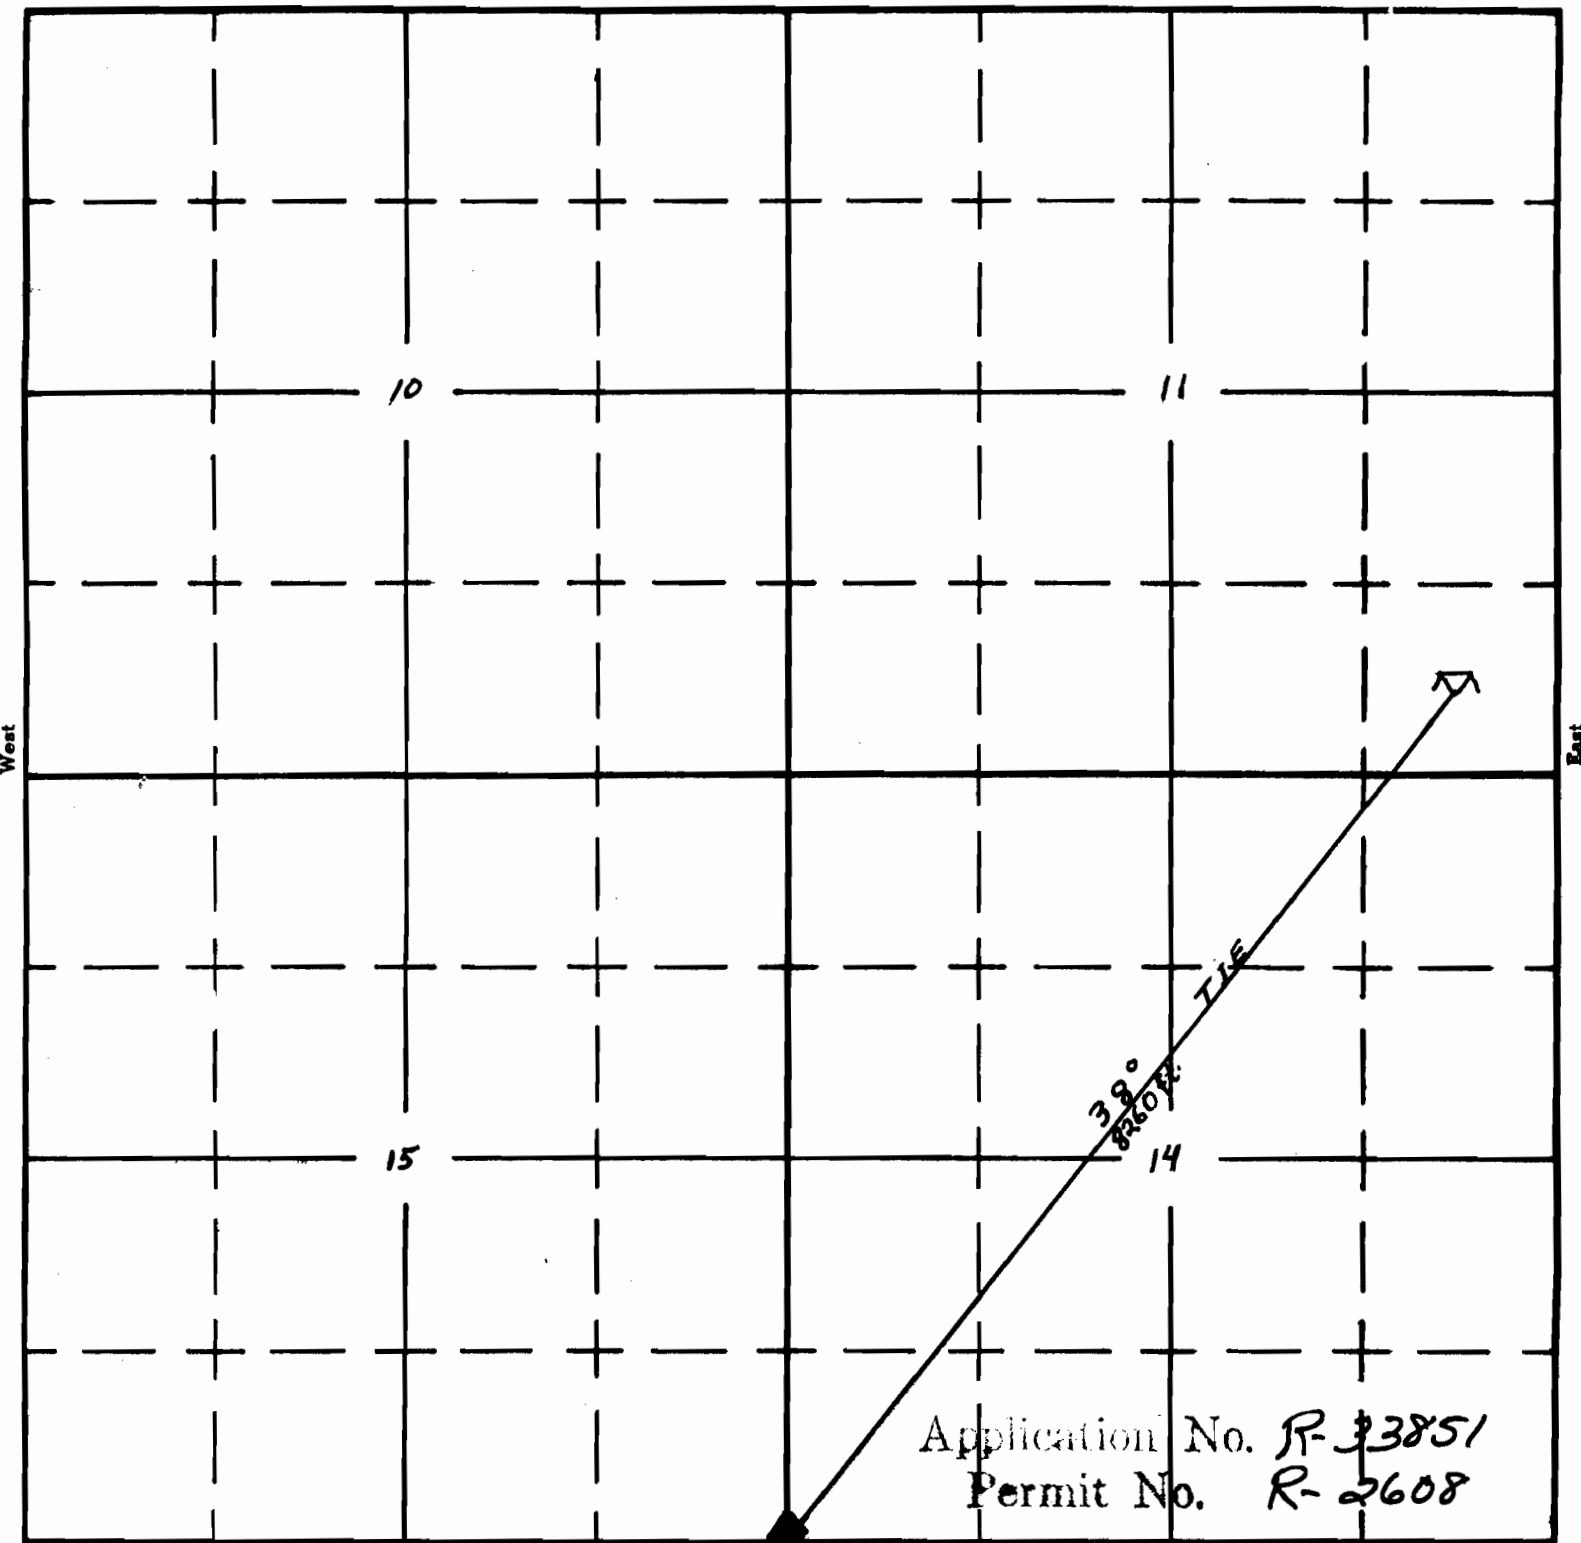

Legend.

- ◆-Found Survey Corner
- R- Water hole

Application No. R-33851
Permit No. R-2608

APPLICATION No.

PERMIT No.