

UNITED STATES  
DEPARTMENT OF THE INTERIOR  
BUREAU OF LAND MANAGEMENT


Canary Flat  
Waterhole  
05-R-26

SECTION  
32  
\_\_\_\_\_  
\_\_\_\_\_  
\_\_\_\_\_


TOWNSHIP 22 S., RANGE 21 E., W. M.

North

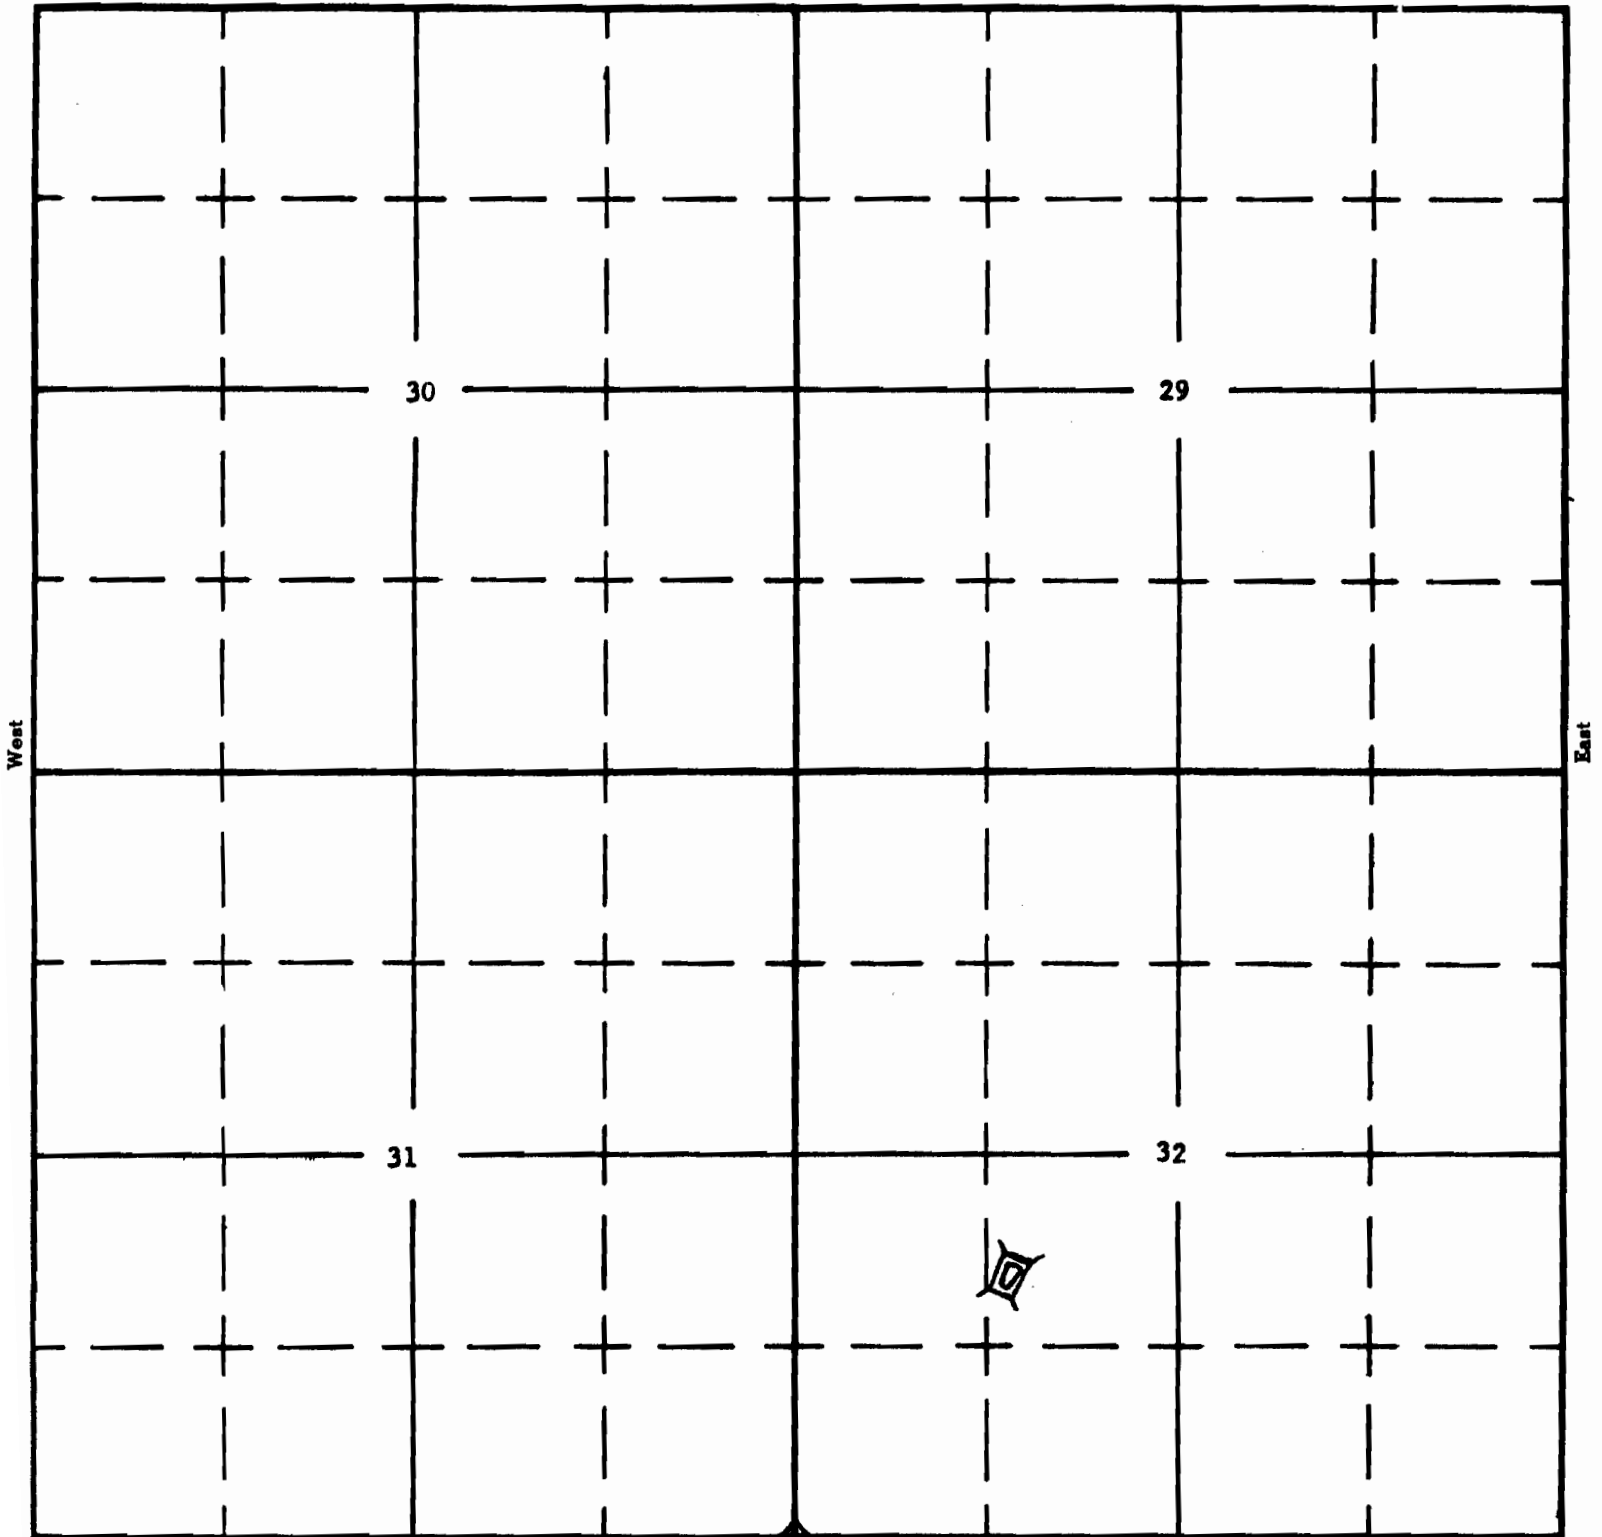

South

APPLICATION No. 34744  
PERMIT No. P-2618