

UNITED STATES
DEPARTMENT OF THE INTERIOR
BUREAU OF LAND MANAGEMENT

Ram Lake Waterhole
05-R-28


SECTION

25

Oregon State Water Filings

TOWNSHIP 22 S., RANGE 19 E., W. M.

North

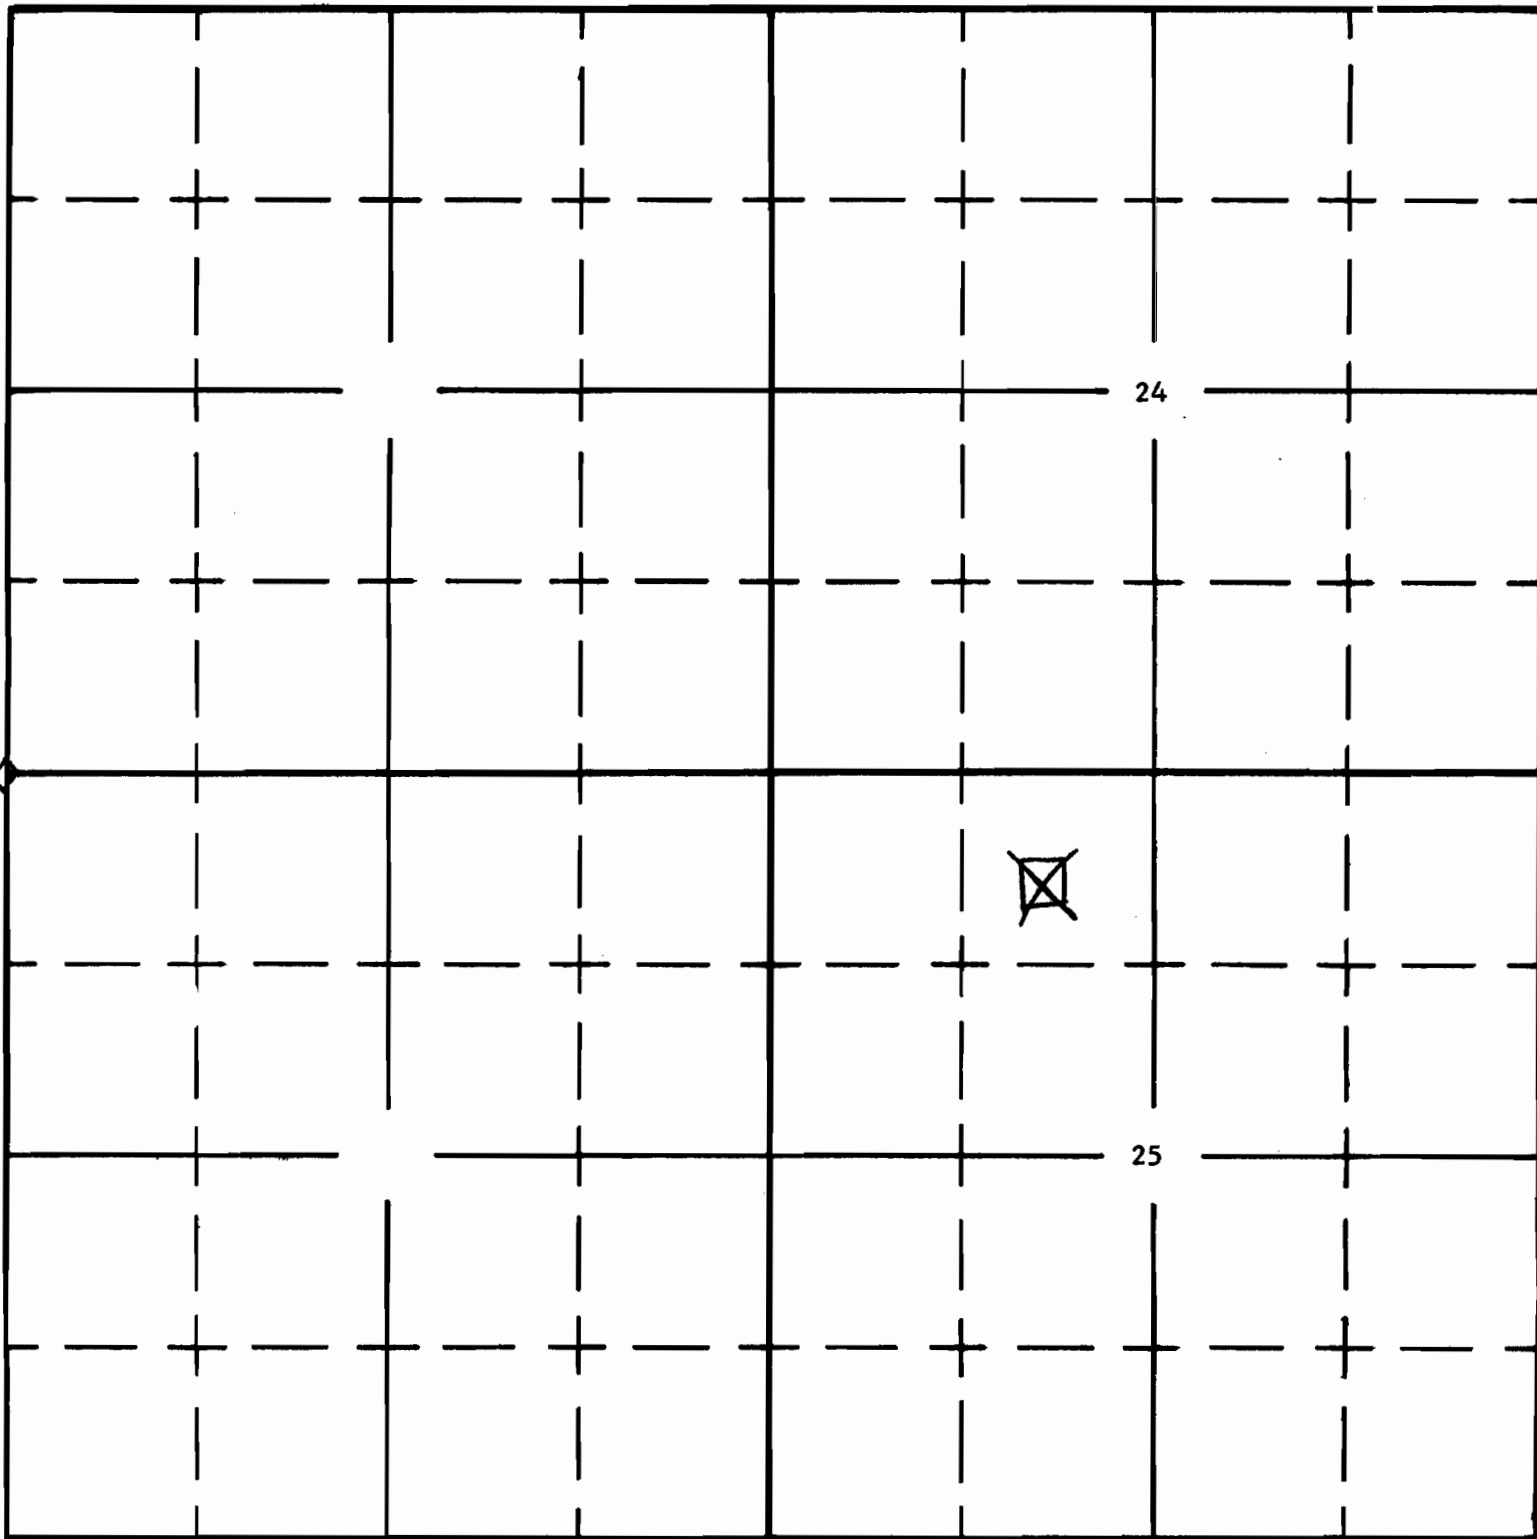

South

APPLICATION No. *R-2619*

PERMIT No. *R-2619*