

UNITED STATES
DEPARTMENT OF THE INTERIOR
BUREAU OF LAND MANAGEMENT


Ram Lake South
Waterhole
05-R-27

SECTION 25

Oregon State Water Filings

TOWNSHIP 22 S., RANGE 19 E., W. M.

North

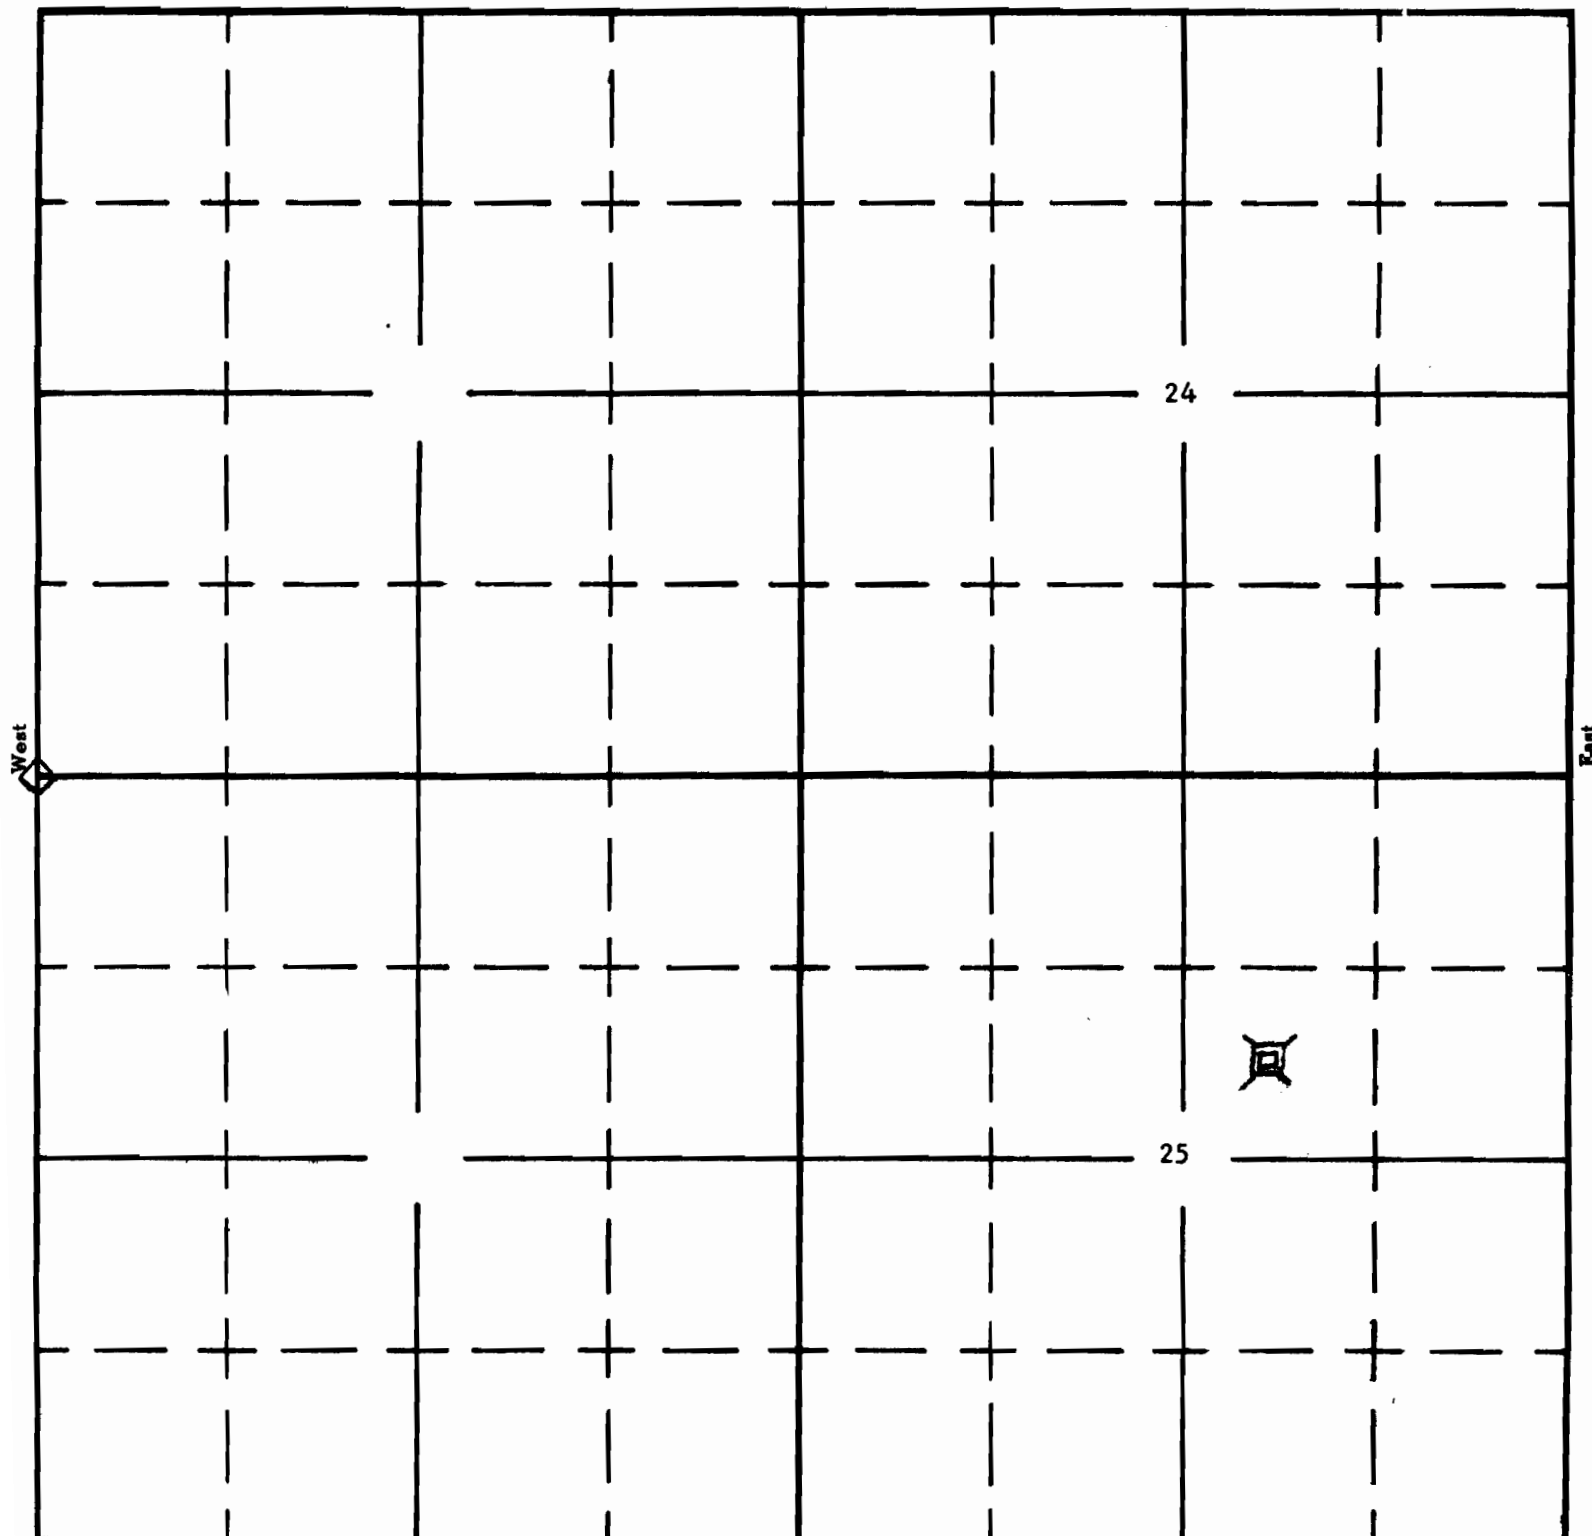

South

APPLICATION No. R 34746

PERMIT No. R 2630