

R-2626
62777

Form AI-187
March 1961

UNITED STATES
DEPARTMENT OF THE INTERIOR
BUREAU OF LAND MANAGEMENT

SECTION


12

Oregon State Water Filings

TOWNSHIP 40-S, RANGE 10-E, W. M.

North

Lost Re. Misc.

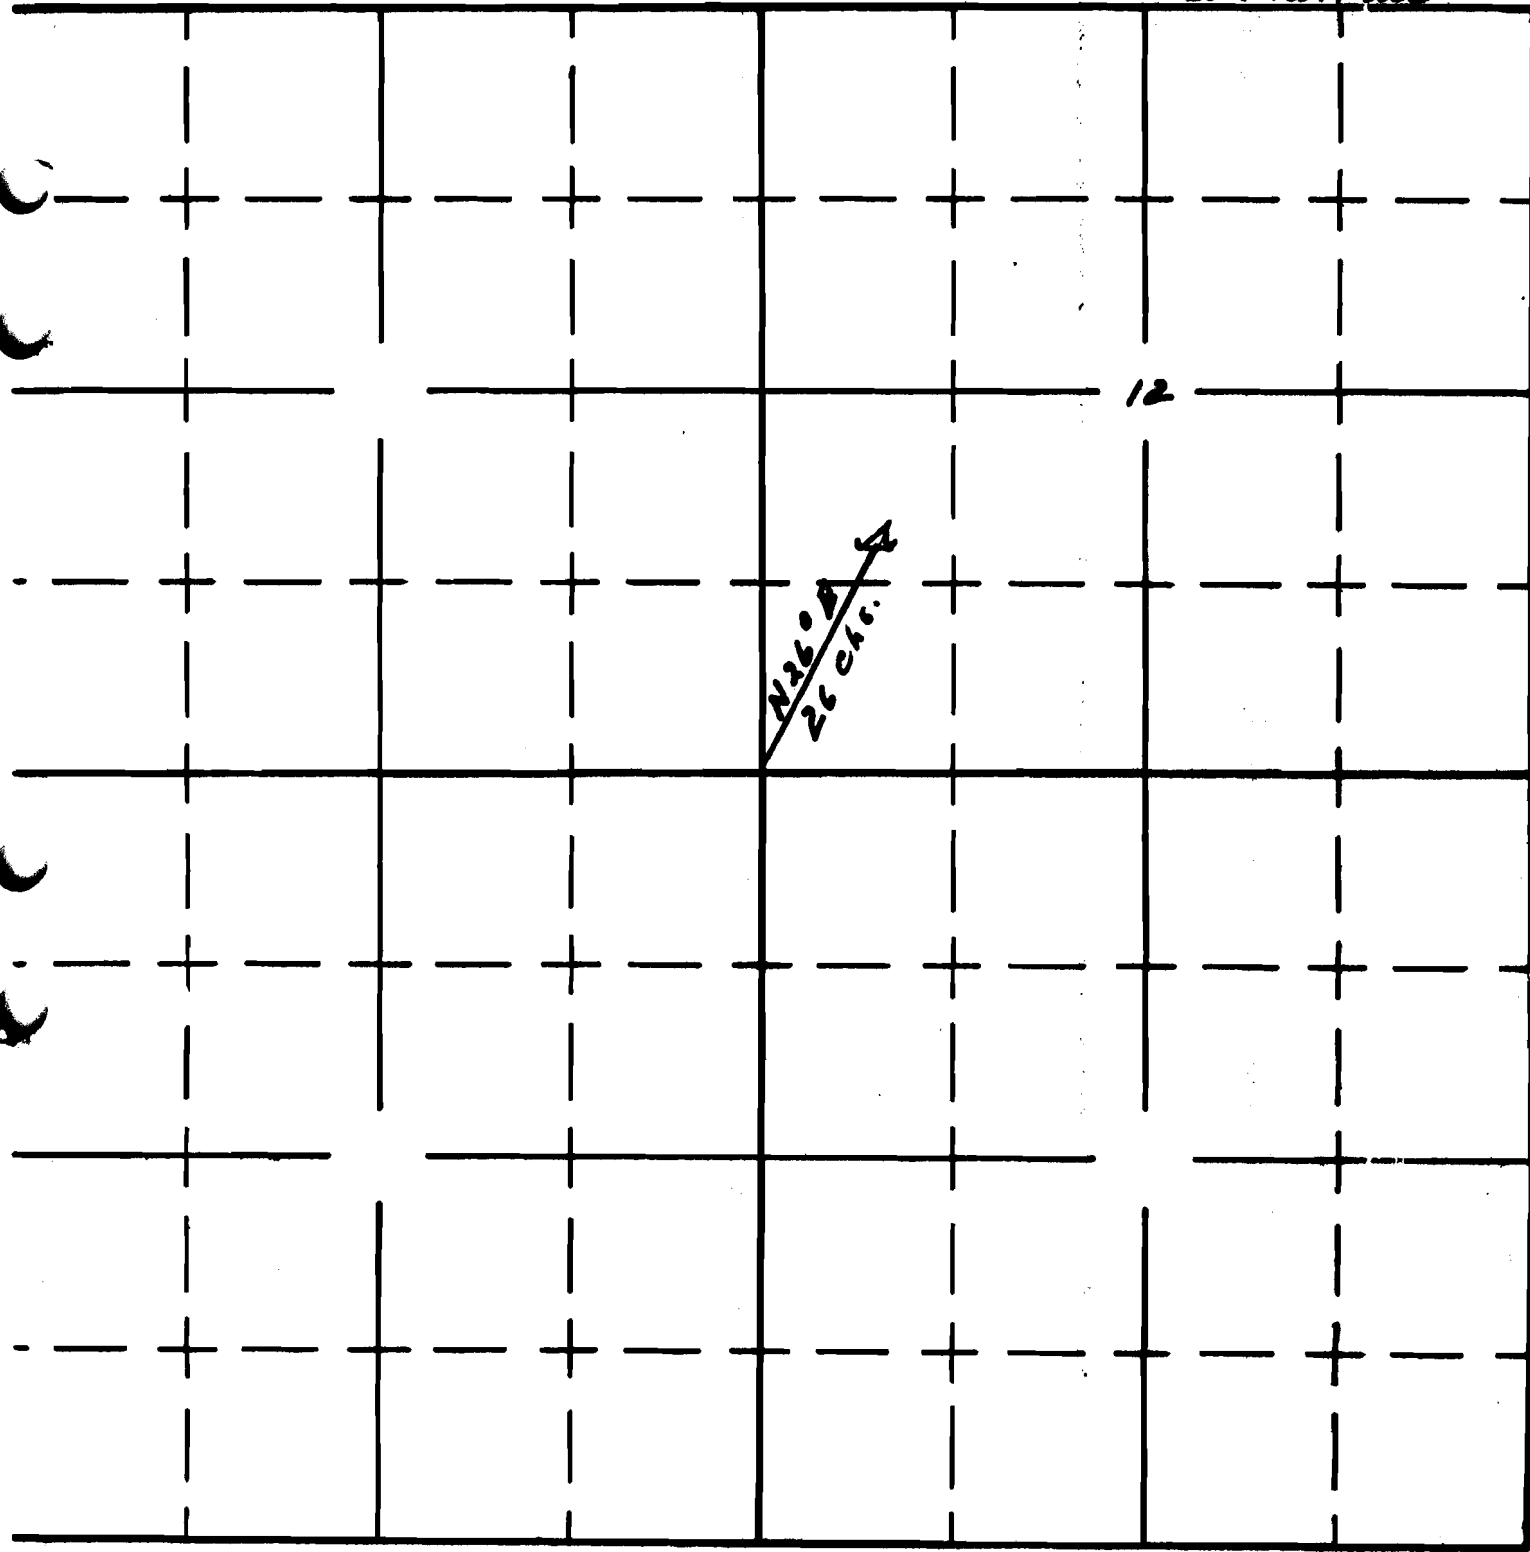

South

APPLICATION No. R-34817