

Form A1-187
March 1961

UNITED STATES
DEPARTMENT OF THE INTERIOR
BUREAU OF LAND MANAGEMENT

SECTION

Oregon State Water Filings


2

TOWNSHIP 20S, RANGE 38E, W. M.

RECEIVED

JAN 1 1962

STATE ENGINEER
SALEM, OREGON

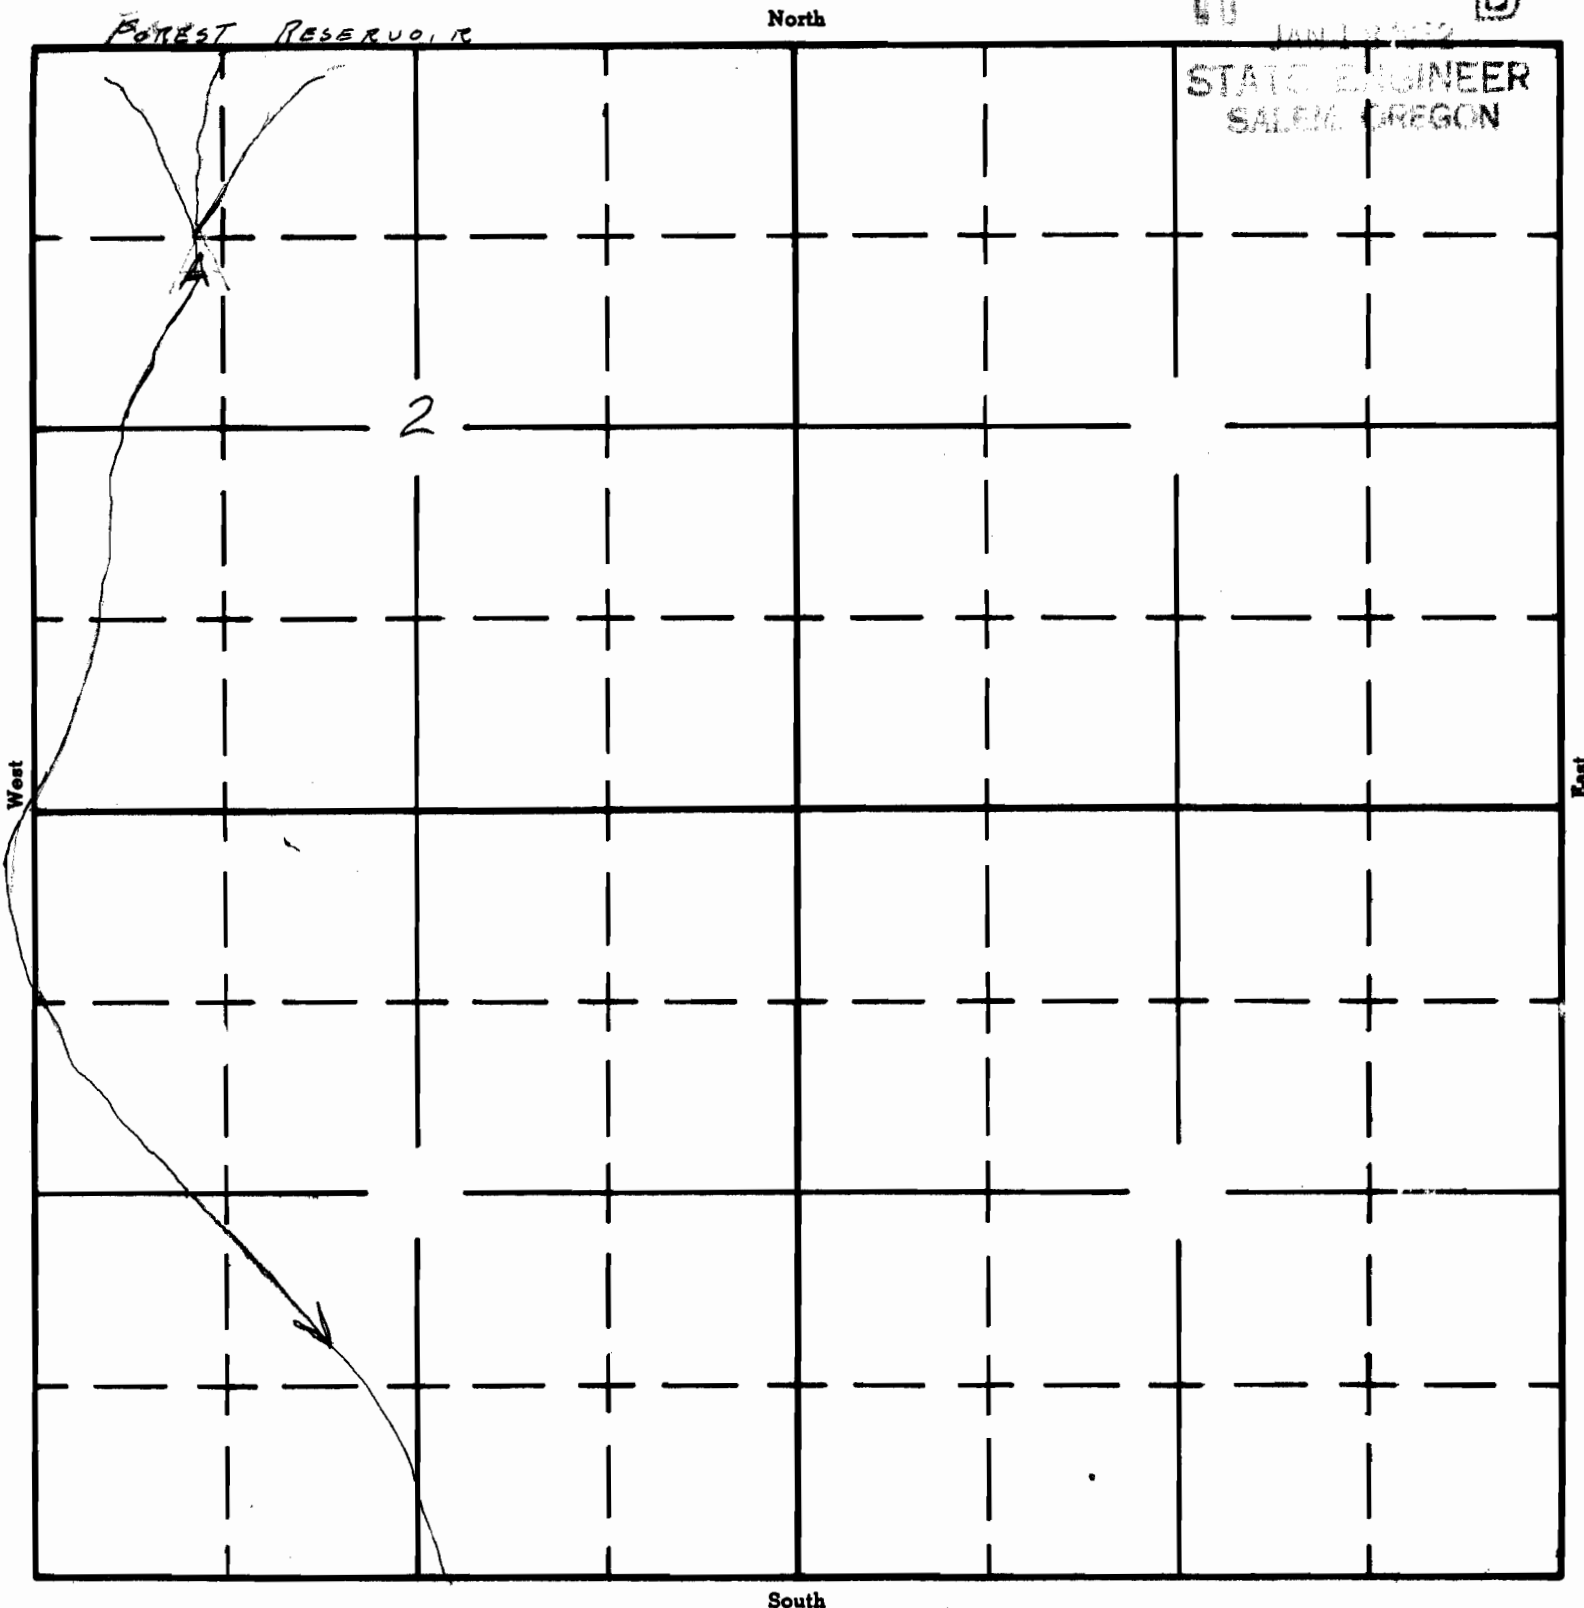

APPLICATION No. R-37288
PERMIT No. R-2720