

UNITED STATES
DEPARTMENT OF THE INTERIOR
BUREAU OF LAND MANAGEMENT


SECTION

29
W 1/2 SW 1/4

Oregon State Water Filings

TOWNSHIP 23S, RANGE 24E, W. M.

North

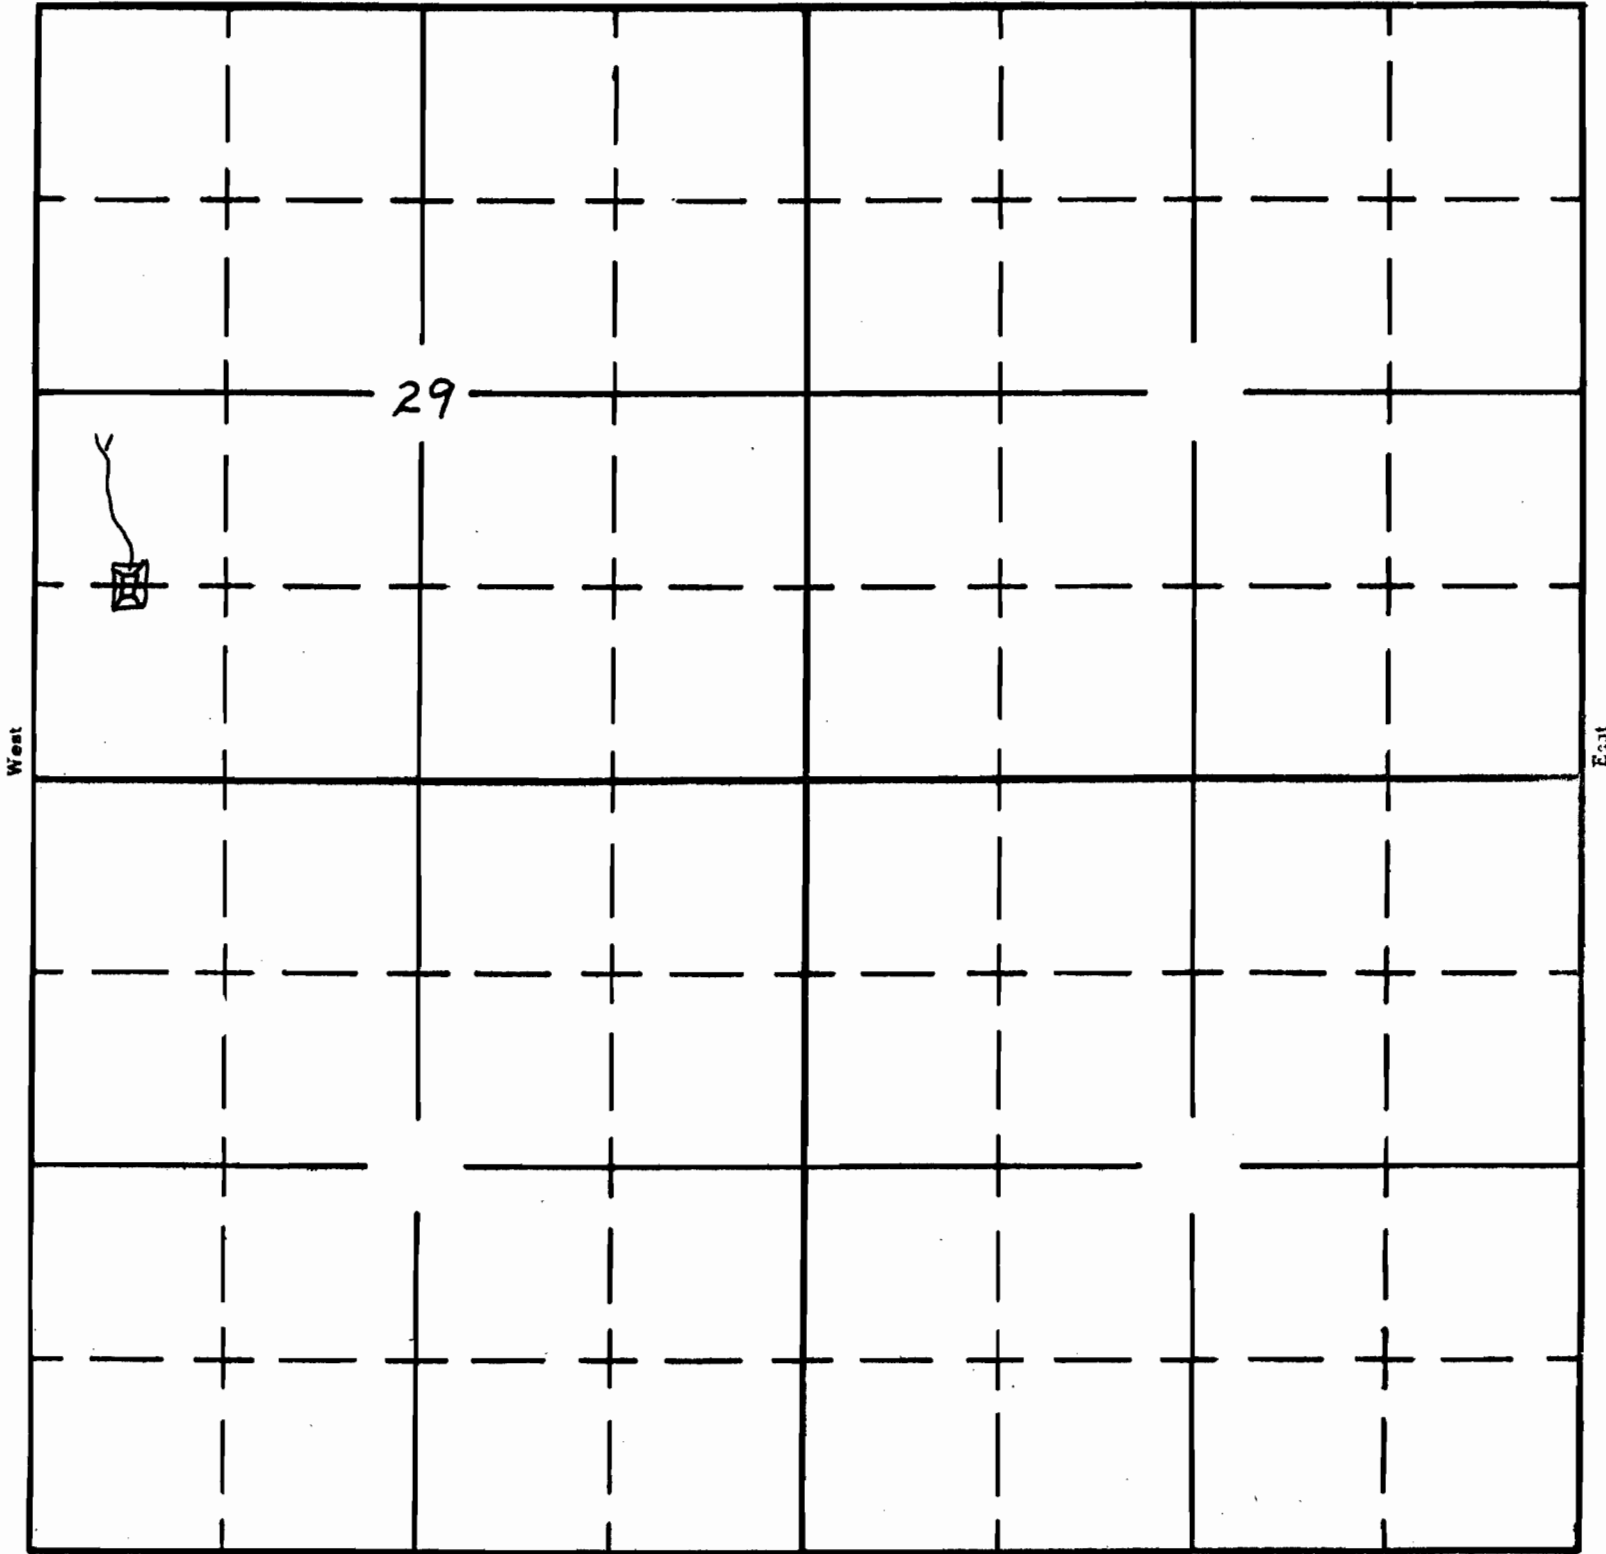

South

APPLICATION No. R-34907

PERMIT No. R-2763