

UNITED STATES
DEPARTMENT OF THE INTERIOR
BUREAU OF LAND MANAGEMENT

SECTION


23

NE 1/4 SE 1/4

Oregon State Water Filings

TOWNSHIP 23S, RANGE 24E, W. M.

North

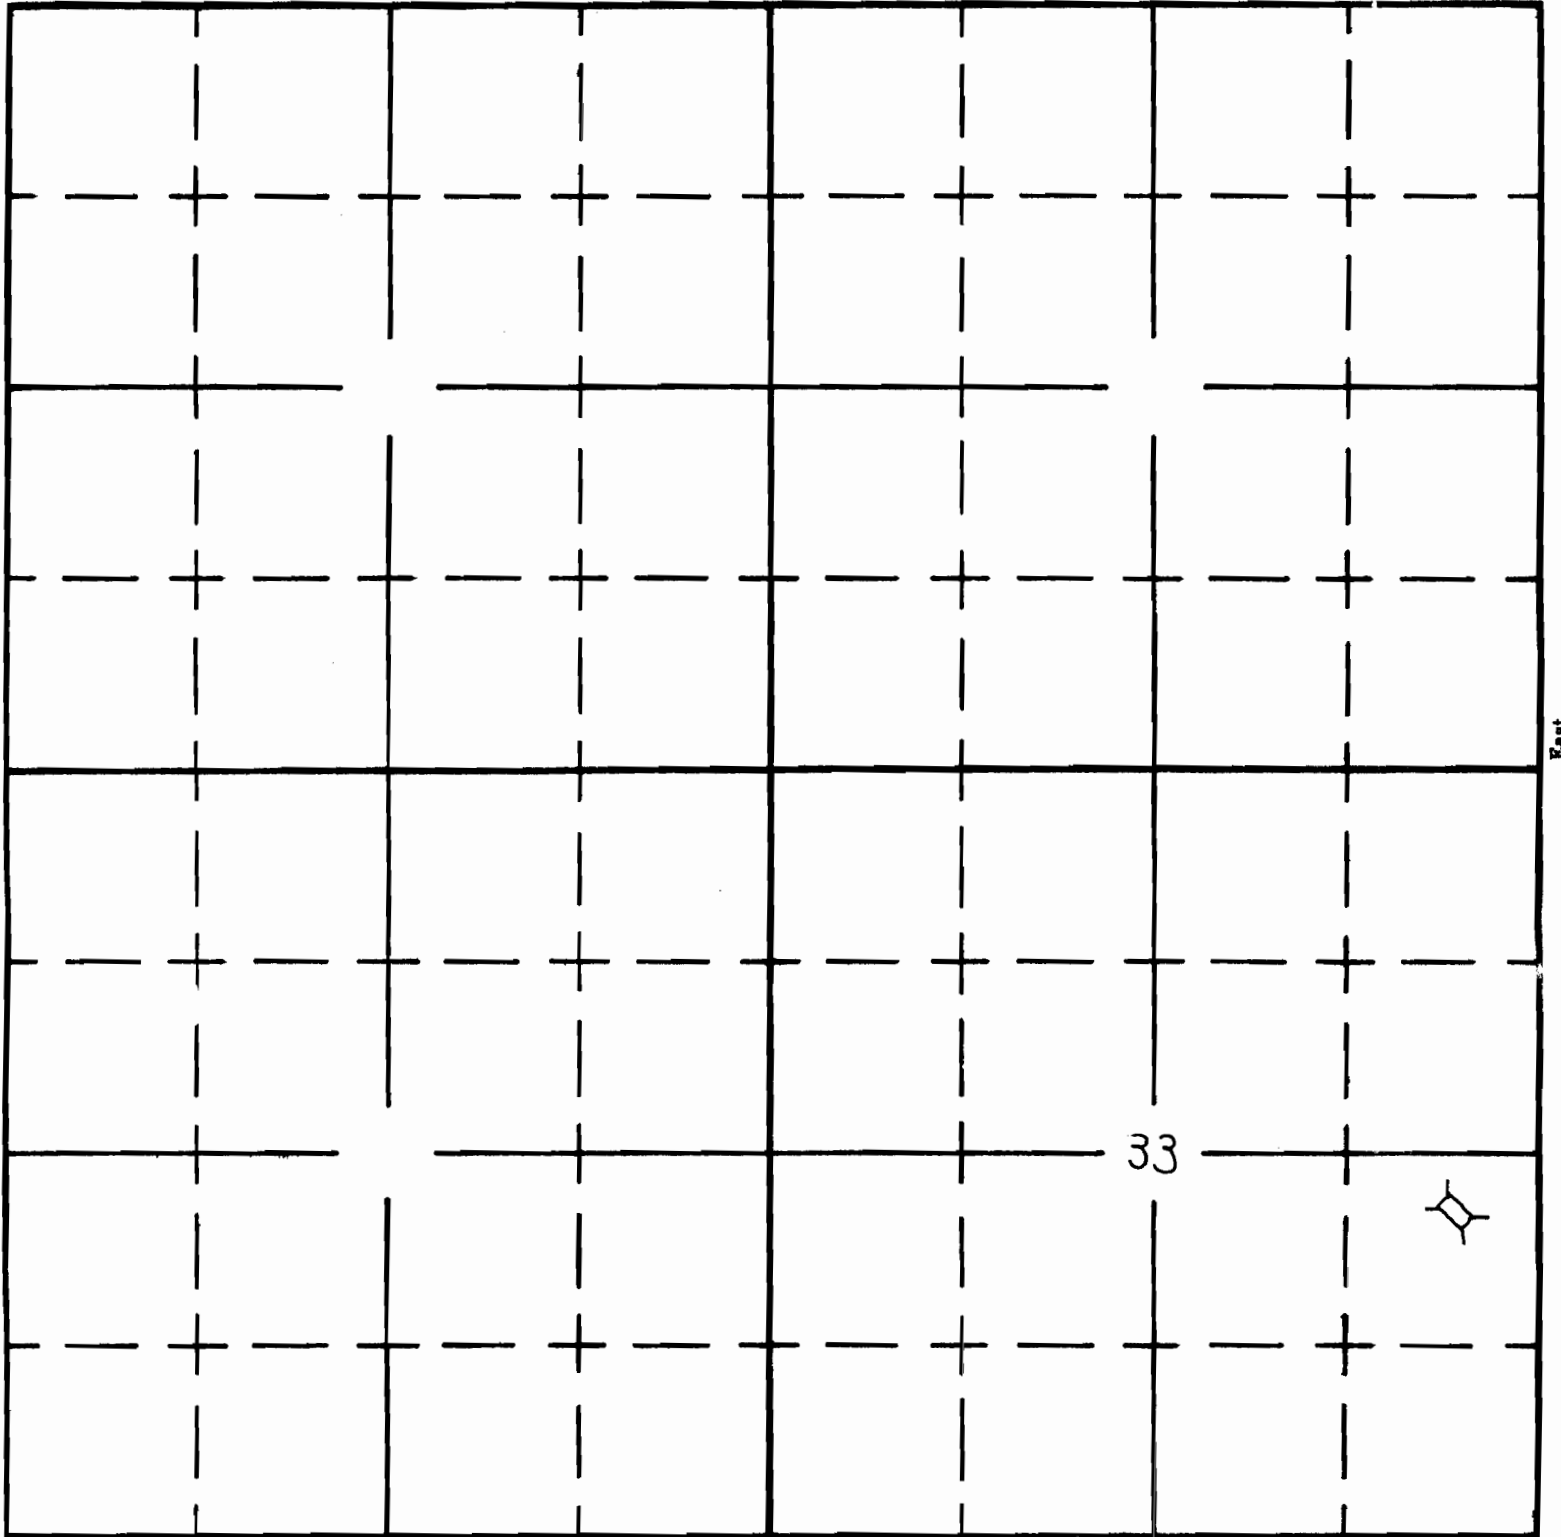

South

APPLICATION No. R-34913

PERMIT No. R-2769