

N-2174
62788

UNITED STATES
DEPARTMENT OF THE INTERIOR
BUREAU OF LAND MANAGEMENT

SECTION


14

Oregon State Water Filings

TOWNSHIP 37S, RANGE 10E, W. M.

North

Sunn Lake & Misc.

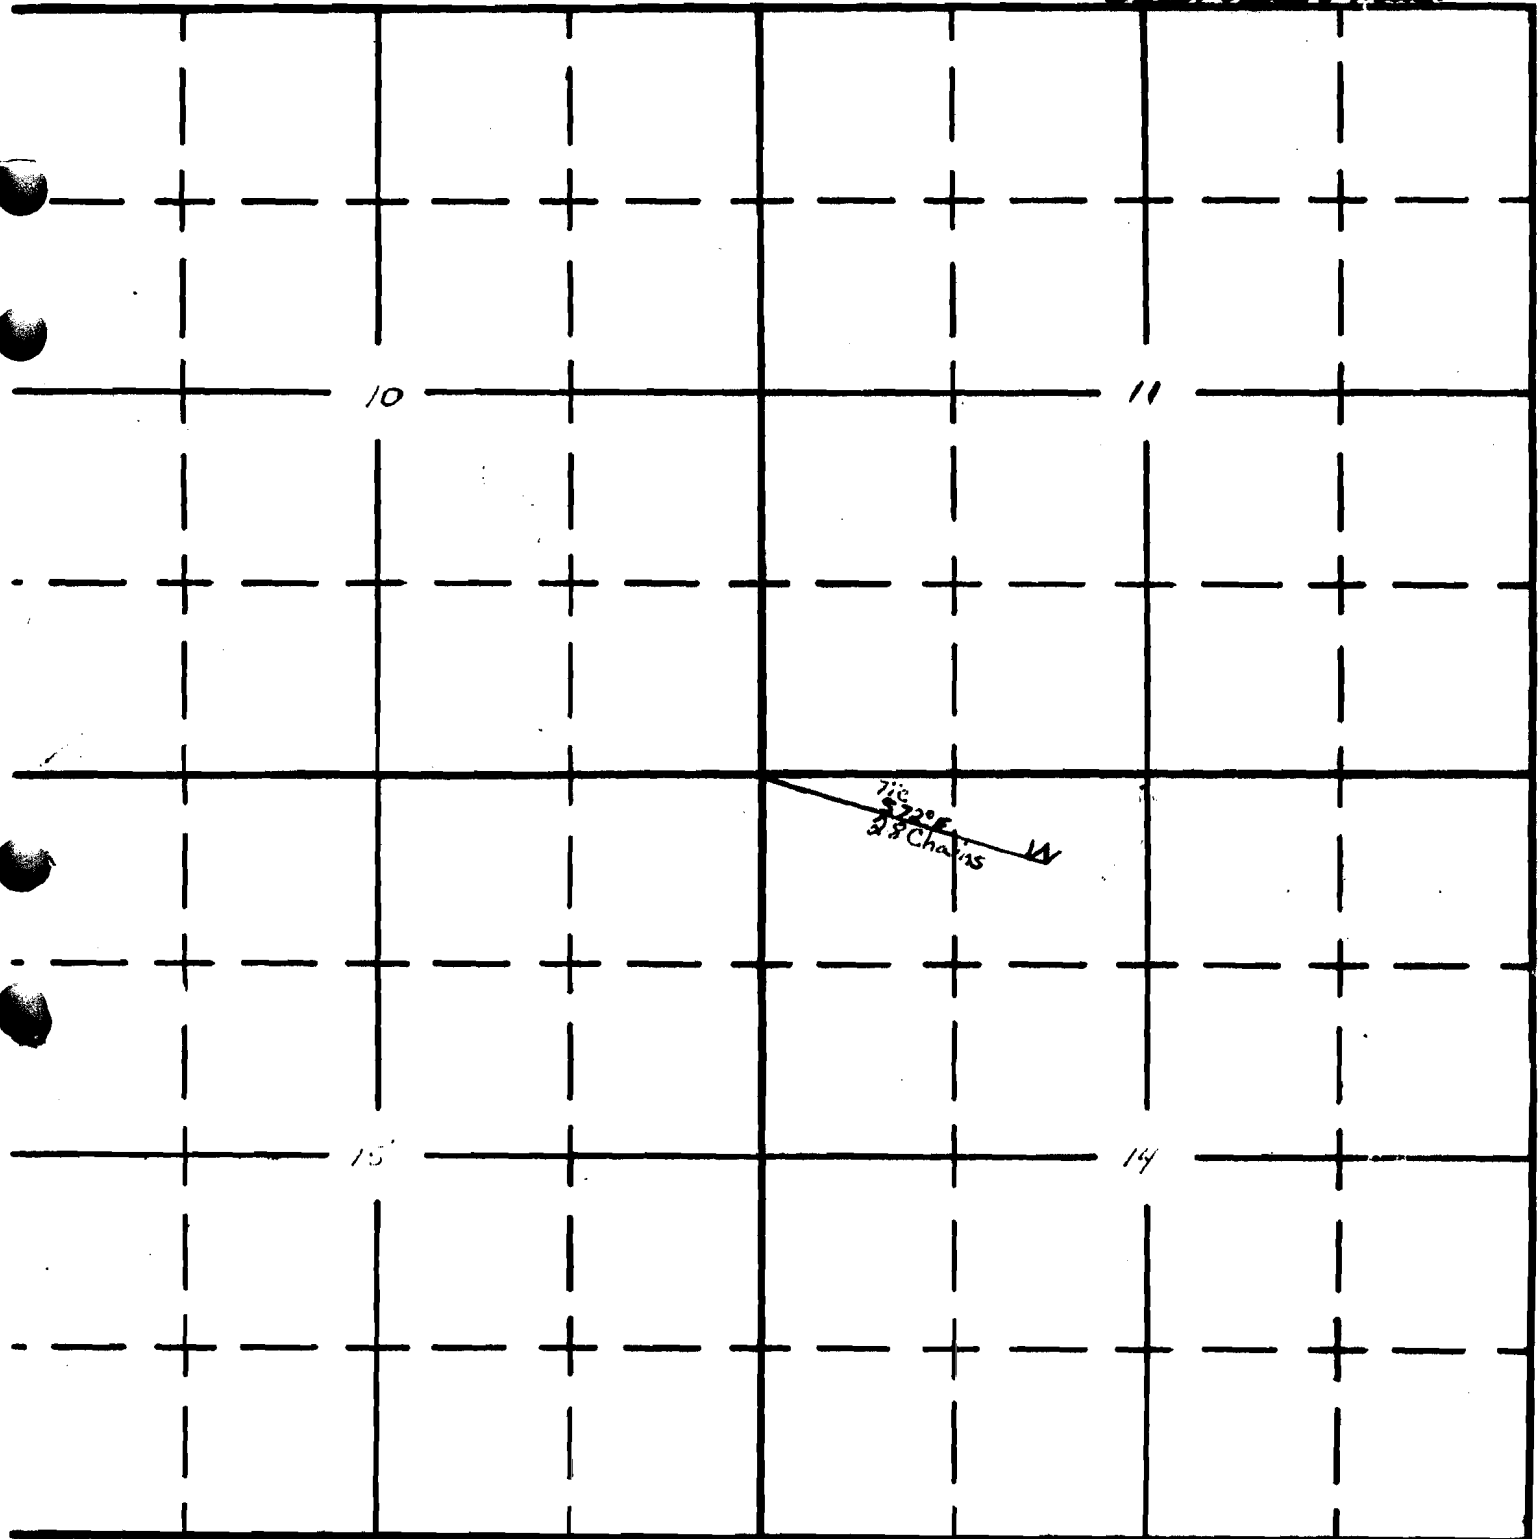

Red in with 400/200/02

South

APPLICATION No. R-34694