


rm A1-187
rch 1961

UNITED STATES
DEPARTMENT OF THE INTERIOR
BUREAU OF LAND MANAGEMENT

R-2839
62791

SECTION 3 Oregon State Water Filings

NE 1/4 NW 1/4 TOWNSHIP 40 S, RANGE 10 E, W. M.

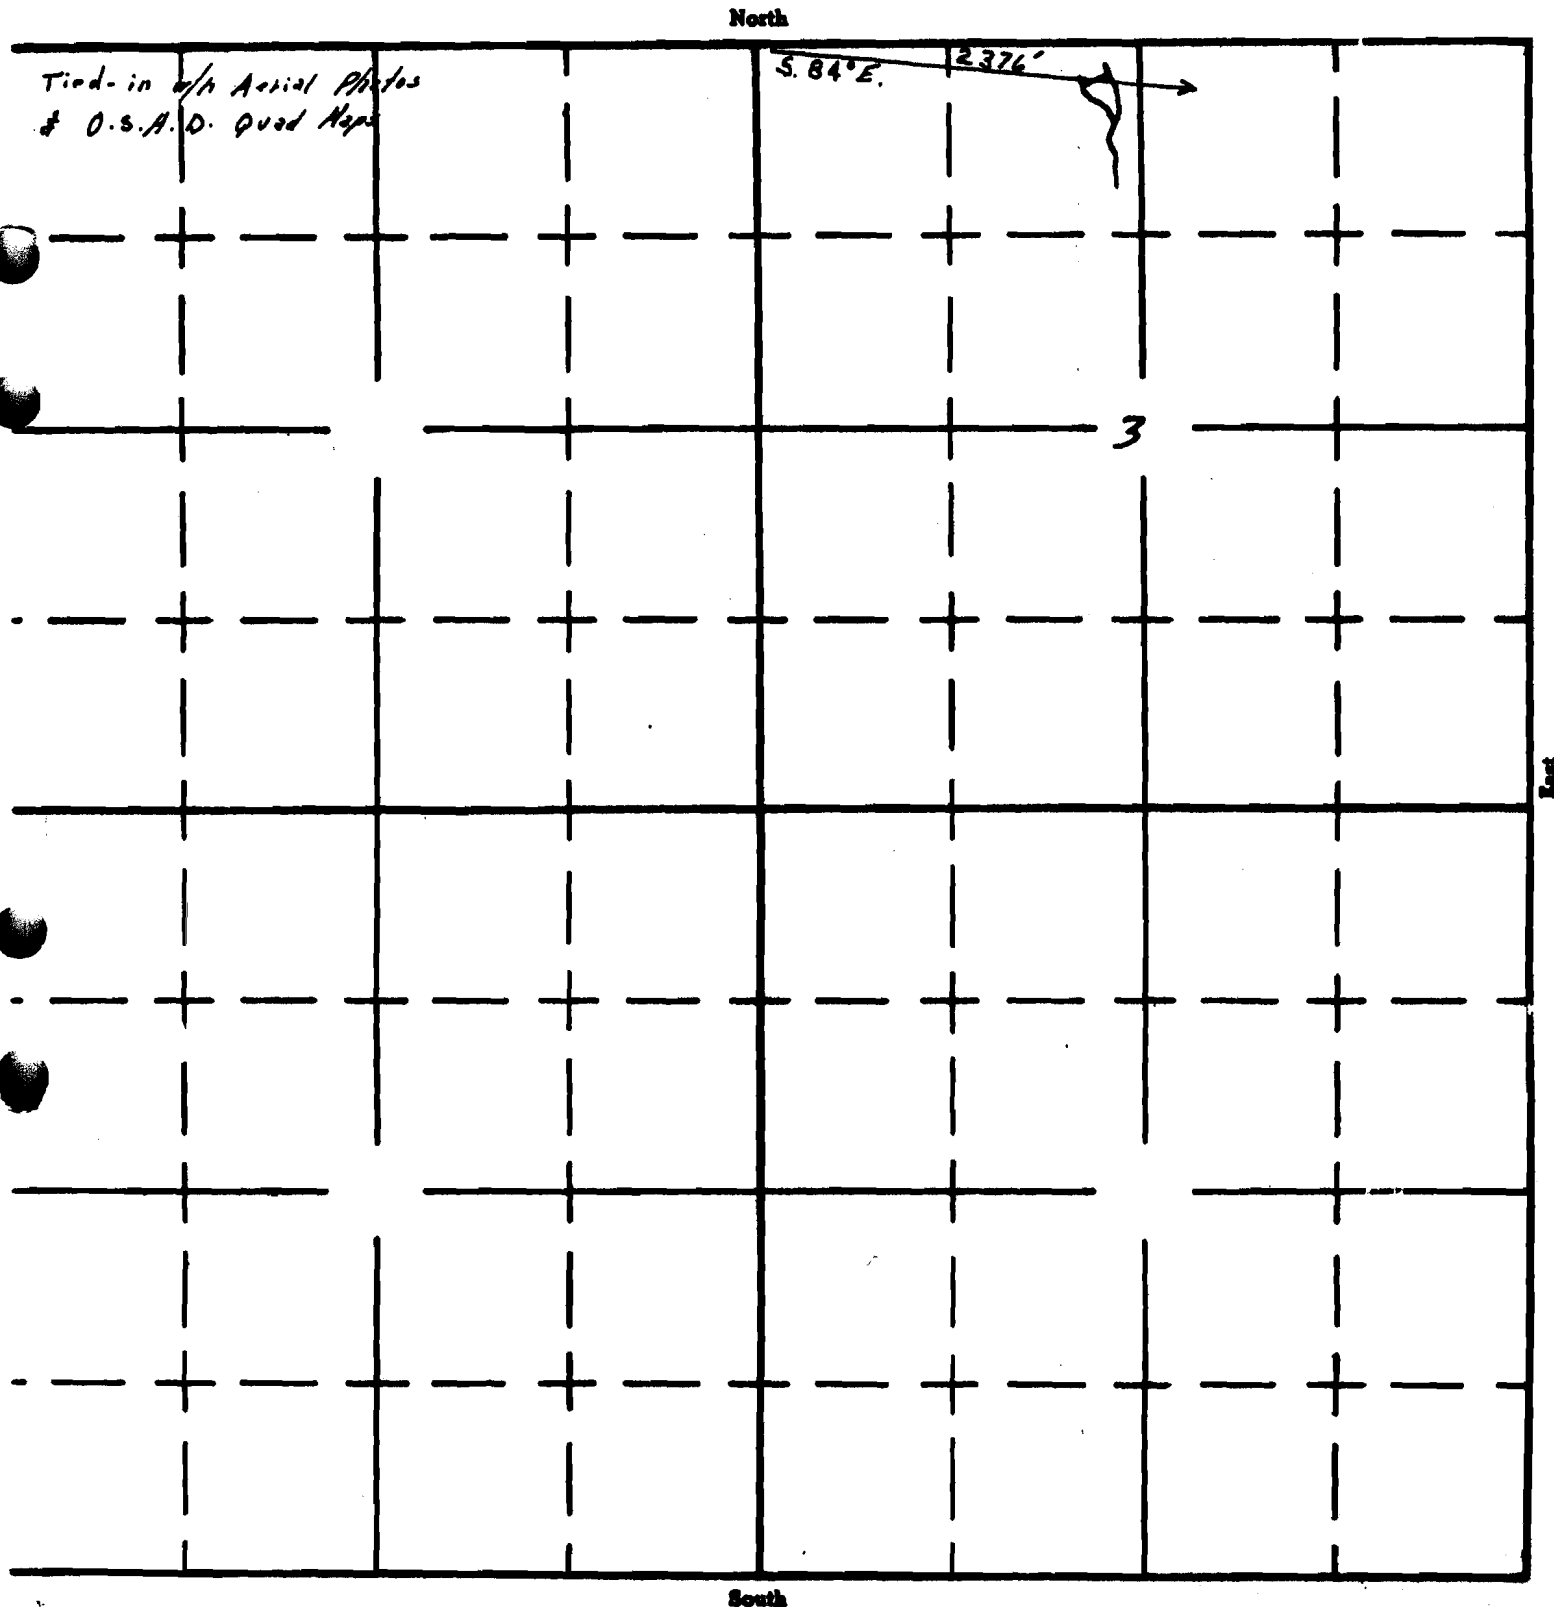

APPLICATION No. R-3513

PERMIT No. R-2839